K 3045

Hancock

~~N 286~~

9-67

MISSISSIPPI
BOARD OF WATER COMMISSIONERS
416 North State Street
Jackson, Mississippi 39201

WATER WELL DRILLERS LOG

9-8 1967 Sutter Well Works Hancock

date well completed — firm name — county well located

LANDOWNER: James Lagasse

Waveland

Miss

(mailing address)

WELL LOCATION:

sec. ____ T 9 N (S) R 14 E (W)

____ miles N of Waveland

(distance) (direction) (nearest town)

WELL PURPOSE: Home

(home, irrigation, municipal, industrial)

WELL COMPLETION DATA:

(1) diameter (inches) 2" 1¼

(2) total depth (feet) 171

(3) static water level (feet) 8 below ~~above~~ top of ground.

(4) casing galv. (material), 166 (depth), 1¼" (size) If telescope see back.

(5) screen 5" (length), 166 (depth to top) 2" 1¼" (size), wire gauze (material)

(6) pump unknown (HP) (yield gpm)

____ (type power)

(7) electric log no (yes or no)

____ (organization running log)

(8) how well bottom plugged BP Valve

DRILLERS REMARKS: Owner furnished all material.

description of formations encountered	from	to
Old Well	0	50
Clay	50	95
Sand	95	105
Clay	105	156
Sand	156	171

RECEIVED OCT 3 1967 MISS. BOARD OF WATER COMM.

If well telescopes please sketch and show depths.

GROUND LEVEL

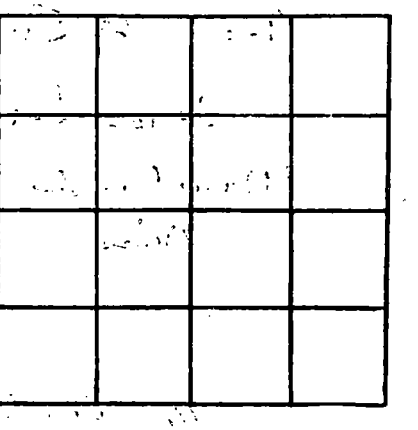

SECTION _____

Please indicate well location X.

ADDITIONAL INFORMATION

If more than one screen, show locations of each on sketch.