MISSISSIPPI DEPARTMENT OF NATURAL RESOURCES

Bureau of Land and Water Resources

P.O. Box 10631
Jackson, Mississippi 39209

WATER WELL DRILLERS LOG

COUNTY WELL LOCATED	Hancock
WELL NUMBER / CODED	L-2987
DATE WELL COMPLETED	10-23-87
PERMIT NUMBER	
NAME OF DRILLING FIRM	Ward Well Drilling
	Rt. 2 Box 350C, B.S., Ms

NAME & MAILING ADDRESS OF LANDOWNER: Nathan Acker, White Bayou Rd, Pearlington, Ms.

WELL LOCATION: SEC 37 TOWNSHIP 9 N (S) RANGE 16 E (W)

DISTANCE — Miles DIRECTION — of NEAREST TOWN Pearlington

OTHER LANDMARK: Pearlington

WELL PURPOSE: Home, Irrigation, Municipal, Industrial, Fish Pond, etc.: Home

PUMP DATA

PUMP TYPE (Circle One): Submersible, Turbine, Jet, Flowing Well, Other (Describe) Owner

POWER TYPE (Circle One): Electric, Tractor, Diesel, Gasoline, Butane, Other (Describe)

Pump Capacity (GPM)	No. of Stages	Setting Depth
		FT.

PUMP TEST

Well yielded _____ GPM with a drawdown of _____ ft. after _____ hours of pumping

WELL DATA

Well Depth	Casing Diameter (In.)	Casing Length (Ft.)
126 ft.	2"	116 ft.

Type of Casing	Hole Depth	Depth to Static Water Level
Sch 40 PVC	126 ft.	-10 ft.

TYPE OF COMPLETION (Circle One or More): Gravel Packed, Underreamed, Telescoped, Natural Development, Open Hole, Other (Describe) Backwash - air

Top of Lap Pipe or Reduction in Casing: FEET — IF TELESCOPED OR MORE THAN ONE SCREEN: USE BACK PAGE

LOG DATA

TYPE OF LOG RUN (Circle One): No Log Run, Electric, Gamma Ray, Density, Sonic, Neutron, Other (Describe)

Name of Organization Running Log

GEOLOGIC DATA (Office Use Only)

Surface Elev.	Geologic Unit	Unit Thickness	Depth to Top
Subs. SWL	Date	Analysis	Aquifer Test

Driller's Remarks: N/A

SCREEN DATA

Diameter - Inches	Length - Feet	Slot Size - Inches
2"	10 ft.	.008

Screen Type	Depth to Bottom - Feet
Sch. 80 PVC	126

RECEIVED DEC 14 1987 Department of Natural Resources Bureau of Land & Water Resources

DESCRIPTION OF FORMATIONS ENCOUNTERED	FROM	TO
Clay	0	18
Sd	18	46
Red Gravel - Sd	46	52
Clay	52	105
Coarse Sd	105	126

FORMATIONS (Continued)	FROM	TO

IF MORE SPACE IS NEEDED, USE BACK

If well telescopes please sketch and show depths.

GROUND LEVEL

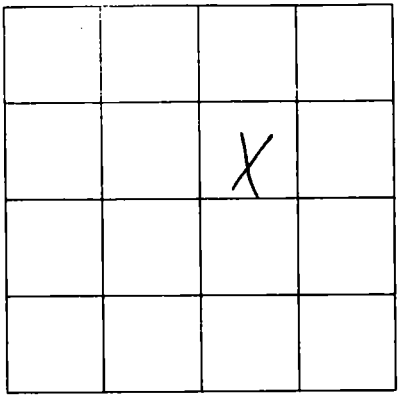

SECTION 37

Please indicate well location X.

ADDITIONAL INFORMATION

If more than one screen, show location of each on sketch.