MISSISSIPPI DEPARTMENT OF ENVIRONMENTAL QUALITY
Office of Land and Water Resources

P. O. Box 10631
Jackson, MS 39289-0631

WATER WELL DRILLERS LOG

COUNTY WELL LOCATED: Hancock	
WELL NUMBER: L 2110	CODED:
PERMIT NUMBER: O-239	
NAME OF DRILLING FIRM: McGill	
DATE WELL COMPLETED: 1-10-93	

NAME & MAILING ADDRESS OF LANDOWNER
Tom Haden

Perkinston

WELL LOCATION: SEC 19 TOWNSHIP 9 N (S) RANGE 16 E (W)

DISTANCE: 3 Miles DIRECTION: W of NEAREST TOWN: Perkinston

OTHER LANDMARK

WELL PURPOSE: Home, Irrigation, Municipal, Industrial, Fish Pond, etc.

PUMP DATA

PUMP TYPE (Circle One):
Submersible, Turbine, Jet, Flowing Well,
Other (Describe) No Pump

POWER TYPE (Circle One):
Electric, Tractor, Diesel, Gasoline, Butane,
Other (Describe) H/P

Pump Capacity (GPM)	No. of Stages	Setting Depth
		FT.

PUMP TEST
Well yielded GPM with
a drawdown of ft.
after hours of pumping

WELL DATA

Well Depth	Casing Diameter (In.)	Casing Length (Ft.)
500	2	480
Type of Casing	**Hole Depth**	**Depth to Static Water Level**
PVC	500	0

TYPE OF COMPLETION: (Circle One or More):
Gravel Packed, Underreamed, Telescoped,
Natural Development, Open Hole, Other
(Describe)

WELL GROUTED TO A DEPTH OF 10 FEET
Type Grout (circle one): Cement, Bentonite, or Mix

LOG DATA

TYPE OF LOG RUN (Circle One): No Log Run,
Electric, Gamma Ray, Density, Sonic, Neutron,
Other (Describe)

Name of Organization Running Log

RECEIVED
FEB 00 1994
Dept. of Environmental Quality
Office of Land & Water Resources

GEOLOGIC DATA (Office Use Only)

Surface Elev.	Geologic Unit	Unit Thickness	Depth to Top
Subs. SWL	Date	Analysis	Aquifer Test

Driller's Remarks

Top of Lap Pipe or Reduction in Casing
FEET

IF TELESCOPED OR MORE THAN ONE SCREEN: USE BACK PAGE

SCREEN DATA

Diameter - Inches	Length - Feet	Slot Size - Inches
2	20	6
Screen Type		**Depth to Bottom - Feet**
PVC		500

DESCRIPTION OF FORMATIONS ENCOUNTERED	FROM	TO
Mud - Sand	0	20
Sand	20	120
Mud	120	140
Mud - Sand	140	220
Sand	220	240
Sand - Mud	240	260
Mud	260	300
Sand	300	340
Sand - Mud	340	380
Mud	380	420

FORMATIONS (Continued)	FROM	TO
Mud - Sand	420	440
Sand	440	500

IF MORE SPACE IS NEEDED, USE BACK

If well telescopes please sketch and show depths.

GROUND LEVEL

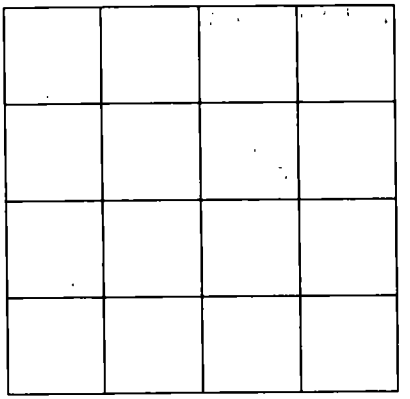

SECTION _____

Please indicate well location X.

ADDITIONAL INFORMATION

If more than one screen, show location of each on sketch.