

County: Hancock
 Permit #: _____
 Driller: Necaise Well Service
 Date drilling completed: 5-31-08

State Well Report
Part 1 - Driller's Log
 Mississippi Department of Environmental Quality
 Office of Land and Water Resources
 P.O. Box 2309
 Jackson, MS 39225
 (601)961-5210
 (601)360-0525 (fax)

For Office Use Only:
 Aquifer: _____
 Well #: M-134
 L. S. Elevation: _____
 E-log #: _____

State Law requires that this report be prepared by the license holder responsible for the work and filed with the Department at the above address within 30 days of completion of drilling of the well or borehole.

| Information on Well Owner (Landowner if borehole is not for a water well) | Well or Borehole Location |
|--|---|
| Owner Name: <u>Blue Oak Construction</u> | Latitude: _____ Longitude: _____ |
| Mailing Address: <u>7004 W. Gardner St</u> <u># 80070</u> | Method of Lat/Long (circle one): Conventional Survey, USGS quad, Hand-held GPS, Survey-grade GPS |
| <u>Bay St Louis, MS</u> City State Zip Code | <u>12</u> <u>9.5</u> <u>15</u> 1/4 1/4 Sec Twn Rng |
| Telephone No. <u>(601) 549-7718</u> | Distance Direction Nearest Town <u>2</u> Miles <u>N</u> of <u>Zachary</u> |

Well / Borehole Data

Date drilling started: 5-31-08 Date drilling completed: 5-31-08 Hole depth: 110 Hole diameter: 4"

Location of the source of any surface water used for drilling: Zachary City Water & Sewer
 Method of dosing and volume of Chlorine used in drilling and development: _____

Logs run (circle all applicable): (No log run) Electric Gamma Ray Density Sonic Neutron Other: _____
 Name of organization running log(s): _____

Purpose of borehole (check one): Water Well Geotechnical/Geological Investigation _____ Ground Source Heat Pump _____
 Seismic Survey _____ Other (describe) _____
If drilling is not related to water well construction, skip the remainder of this block

Purpose of Well (check one): Home Industrial _____ Public Supply _____ Irrigation _____ Fish Culture _____ Other: _____

If a flowing well, method of flow regulation: Valve _____ Other (describe) _____

Static Water Level: 12 feet above or below (circle one) land surface Date measured: 5-31-08

Method of Measurement (circle one) (steel tape) electric tape air line other: _____

Well depth: 110 Well grouted to a depth of 10 feet Type of grout (circle one): Neat Cement Bentonite (Mix)

Casing length: 100 feet Casing diameter: 2" inches Type of casing: PVC

Screen length: 10 feet Screen diameter: 2" inches Type of screen: PVC

Screen slot size: .006 inches Setting depth: From 100 feet to 110 feet

Type of completion (circle all applicable): (Gravel packed) Underreamed Telescoped Open hole Natural Development
 Other (describe): _____


Top of lap pipe or reduction in casing: _____ feet. *If telescoped or more than one screen, describe on next page*

Form: OLWR-SWR-1A
RECEIVED
 JUN 12 2008
 BY: OLWR

The sketch below only required for water wells

If well telescopes, show depths on sketch.

Ground Level

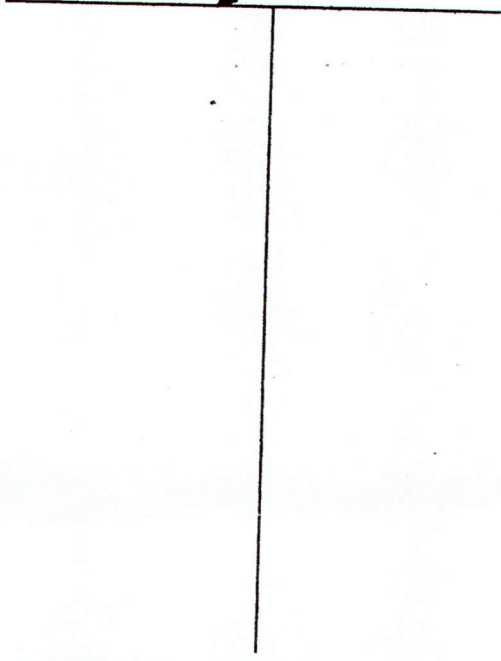


Description of formations encountered must be provided for all wells and boreholes, unless specifically exempted by regulations

| Description of Formations Encountered | From (depth) | To (depth) |
|---------------------------------------|--------------|------------|
| | Ground Level | |
| MUD | 0 | 20 |
| SAND | 20 | 60 |
| CLAY | 60 | 90 |
| SAND | 90 | 110 |
| | | |
| | | |
If more than one screen, show location of each on sketch

Sketch the property layout and include the following: 1) the well location; 2) any permanent structures on the property that may aid in locating the well; 3) any roads, power lines, or other items that may aid in locating the property and the well; 4) a north arrow.

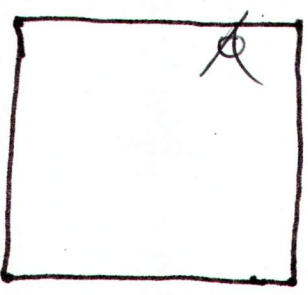

Landowner Name: Blue Oak Construction

Form: OLWR-SWR-1A

I certify that the well/borehole was drilled, constructed, and completed in accordance with all applicable requirements of the Mississippi Department of Environmental Quality and the Mississippi Department of Health regulations, if applicable, and state laws.

Robert Necaize 0-660 5-31-08

RECEIVED

Print Name of Responsible Licensee and License No.

Date

Signature of Licensee

JUN 12 2008

BY: OLWR

STATE WELL REPORT

Part 2

Pump Installer's Completion Report
 Mississippi Department of Environmental Quality
 Office of Land and Water Resources
 P.O. Box 12309
 Jackson, MS 39225
 (601)961-5210
 (601)360-0535

County: Hancock
 Permit #: _____
 Driller: Necaise Well Service
 Date completed: 7-10-08
Copy information from block on Part 1

For Office Use Only:

Aquifer: _____
 Well #: M-134
 Elevation: _____

This part of the report must be completed by a licensed water well contractor or a licensed pump installer. A copy of Part 1 of the report must be attached and both parts filed with the Department at the above address within 30 days of well completion.

| Well Owner Information | Well Location |
|---|---|
| Owner Name: <u>Blue Oak Construction</u> | Latitude: _____ Longitude: _____ |
| Mailing Address: <u>7004 W. GARDNER</u> <u># 80070</u> <u>Bay St Louis MS</u> | Method of Lat/Long (check one): Conventional Survey _____ USGS quad _____, Hand-held GPS _____, Survey-grade GPS _____ _____ 1/4 _____ 1/4 Sec <u>12 T 9 S R 15 W</u> |
| City _____ State _____ Zip Code _____ | Distance _____ Direction _____ Nearest Town _____ |
| Telephone No. <u>239 549-7718</u> | <u>2</u> Miles <u>W</u> of <u>Lakehurst</u> |

| Pump Type Circle one | Power Type Circle one |
|--|---|
| Air Lift _____ Jet _____ Submersible _____ | Diesel Engine _____ Gasoline Engine _____ Natural Gas _____ |
| Bucket _____ Piston _____ Turbine _____ | <u>Electric Motor</u> _____ Hand _____ Tractor PTO _____ |
| <u>Centrifugal</u> _____ Rotary _____ Flowing Well _____ | Windmill _____ Other (specify): _____ |
| Other (specify): _____ | Horse Power Rating of Motor: <u>1</u> |
| Date Pump Installed: <u>7-10-08</u> | Setting Depth: <u>40'</u> feet |
| Rated Pump Capacity: <u>10</u> Gallons Per Minute | Number of Stages: <u>1</u> |

| Pump Test Data | Method of Measuring Water Level Circle one |
|--|---|
| Date Well Tested: _____ | Air Line _____ Electric Measuring Line _____ <u>Steel Tape</u> |
| Static Water Level (A): _____ Feet Below Land Surface | Other (specify): _____ |
| Pumping Water Level (B): _____ Feet Below Land Surface | For flowing well, measured shut in head: _____ feet |
| Drawdown [(B) - (A)]: _____ Feet Below Land Surface | Well yielded _____ GPM with a drawdown of _____ feet after _____ hours of pumping |
| Test Pumping Rate: _____ Gallons Per Minute | |
| Duration of Pump Test (minimum 4 hours): _____ hours | |

I HEREBY CERTIFY that the above statements are true to the best of my knowledge.

Robert Necaise 0-660 _____
 Print Name of Pump Installer and License No. (if applicable) Signature of Pump Installer

Form: OLWR-SWR-1B

RECEIVED

AUG 13 2008

BY: OLWR