MISSISSIPPI DEPARTMENT OF NATURAL RESOURCES

Bureau of Land and Water Resources

P.O. Box 10631
Jackson, Mississippi 39209

WATER WELL DRILLERS LOG

COUNTY WELL LOCATED: HANCOCK

WELL NUMBER: M2113 CODED

DATE WELL COMPLETED: MAY 13 1988

PERMIT NUMBER: 0428

NAME OF DRILLING FIRM: WALKER'S WELL SERVICE

NAME & MAILING ADDRESS OF LANDOWNER: DAVID BREWER
LOT #56 BAYOU DR.
SHORELINE PARK WAVELAND

WELL LOCATION: SEC 31 TOWNSHIP 9 N/S RANGE 14 W/E

DISTANCE 5 Miles DIRECTION S of NEAREST TOWN WAVELAND

OTHER LANDMARK: WAVLAND

WELL PURPOSE: Home, Irrigation, Municipal, Industrial, Fish Pond, etc.

PUMP DATA

PUMP TYPE (Circle One): Submersible, Turbine, Jet, Flowing Well, Other (Describe) _____

POWER TYPE (Circle One): Electric, Tractor, Diesel, Gasoline, Butane, Other (Describe) _____

Pump Capacity (GPM)	No. of Stages	Setting Depth
8	1	25' FT.

PUMP TEST

Well yielded _____ GPM with a drawdown of _____ ft. after _____ hours of pumping

WELL DATA

Well Depth	Casing Diameter (In.)	Casing Length (Ft.)
135'	2"	125'

Type of Casing	Hole Depth	Depth to Static Water Level
PVC	135'	5'

TYPE OF COMPLETION: (Circle One or More): Gravel Packed, Underreamed, Telescoped, Natural Development, Open Hole, Other (Describe) AIR

Top of Lap Pipe or Reduction in Casing FEET

IF TELESCOPED OR MORE THAN ONE SCREEN: USE BACK PAGE

LOG DATA

TYPE OF LOG RUN (Circle One): No Log Run, Electric, Gamma Ray, Density, Sonic, Neutron, Other (Describe) _____

Name of Organization Running Log

GEOLOGIC DATA (Office Use Only)

Surface Elev.	Geologic Unit	Unit Thickness	Depth to Top
Subs. SWL	Date	Analysis	Aquifer Test

Driller's Remarks

SCREEN DATA

Diameter - Inches	Length - Feet	Slot Size - Inches
2"	10'	#10

Screen Type	Depth to Bottom - Feet
SLOT	135

DESCRIPTION OF FORMATIONS ENCOUNTERED	FROM	TO
BLACK CLAY	0	10
SAND	10	15
SANDY CLAY	15	18
SAND	18	65
CLAY	65	100
SAND	100	130

FORMATIONS (Continued)	FROM	TO

IF MORE SPACE IS NEEDED, USE BACK

RECEIVED
MAY 31 1989
Department of Natural Resources
Bureau of Land & Water Resources

If well telescopes please sketch and show depths.

GROUND LEVEL

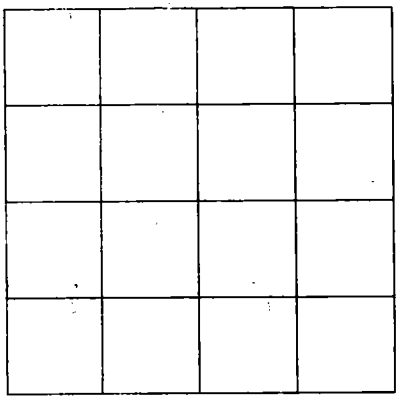

SECTION _____

Please indicate well location X.

ADDITIONAL INFORMATION

If more than one screen, show location of each on sketch.