MISSISSIPPI DEPARTMENT OF ENVIRONMENTAL QUALITY
Office of Land and Water Resources

P. O. Box 10631
Jackson, MS 39289-0631
WATER WELL DRILLERS LOG

COUNTY WELL LOCATED: Hancock	
WELL NUMBER: AA 2120 26	CODED
DATE WELL COMPLETED: 3-24-95	PERMIT NUMBER: 0239
	NAME OF DRILLING FIRM: McGill Pump & Well

NAME & MAILING ADDRESS OF LANDOWNER
Billy Sabugno
P.O. Box 738
Ansley Ms. 39558

WELL LOCATION	SEC	TOWNSHIP	RANGE
	7	9 N (S)	15 E (W)

DISTANCE	DIRECTION	NEAREST TOWN
4 Miles	West of	Waveland

OTHER LANDMARK

WELL PURPOSE: (Home), Irrigation, Municipal, Industrial, Fish Pond, etc.

PUMP DATA

PUMP TYPE (Circle One): Submersible, Turbine, (Jet), Flowing Well, Other (Describe) _____

POWER TYPE (Circle One): (Electric), Tractor, Diesel, Gasoline, Butane, Other (Describe) _____ H/P _____

Pump Capacity (GPM)	No. of Stages	Setting Depth
12	2	40 FT.

PUMP TEST

Well yielded 12 GPM with a drawdown of 10 ft. after 12 hours of pumping

WELL DATA

Well Depth	Casing Diameter (In.)	Casing Length (Ft.)
320	2"	300
Type of Casing	**Hole Depth**	**Depth to Static Water Level**
PVC	320	20

TYPE OF COMPLETION: (Circle One or More): Gravel Packed, Underreamed, Telescoped, (Natural Development), Open Hole, Other (Describe) _____

WELL GROUTED TO A DEPTH OF 10 FEET
Type Grout (circle one): Cement, Bentonite, or Mix

LOG DATA

TYPE OF LOG RUN (Circle One): (No Log Run), Electric, Gamma Ray, Density, Sonic, Neutron, Other (Describe) _____

Name of Organization Running Log

GEOLOGIC DATA (Office Use Only)

Surface Elev.	Geologic Unit	Unit Thickness	Depth to Top
Subs. SWL	Date	Analysis	Aquifer Test

Driller's Remarks

Top of Lap Pipe or Reduction in Casing
FEET — IF TELESCOPED OR MORE THAN ONE SCREEN: USE BACK PAGE

SCREEN DATA

Diameter - Inches	Length - Feet	Slot Size - Inches
2"	20'	.0006
Screen Type	**Depth to Bottom - Feet**	
PVC	320'	

DESCRIPTION OF FORMATIONS ENCOUNTERED	FROM	TO
mud	0	10
sand	10	30
mud	30	160
sand	160	190
mud	190	270
sand	270	320

FORMATIONS (Continued)	FROM	TO

RECEIVED
NOV 07 1995
Dept. of Environmental Quality
Office of Land & Water Resources

IF MORE SPACE IS NEEDED, USE BACK

If well telescopes please sketch and show depths.

GROUND LEVEL

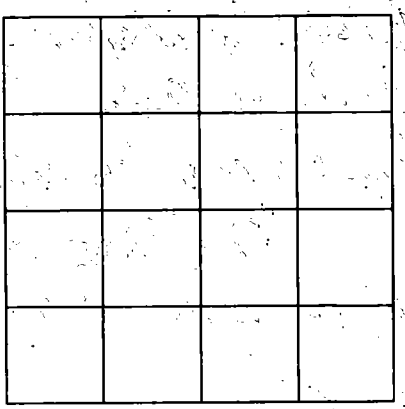

SECTION _____

Please indicate well location X.

ADDITIONAL INFORMATION

If more than one screen, show location of each on sketch.