HARRISON
A28
JAN 19-74

MISSISSIPPI
BOARD OF WATER COMMISSIONERS
416 North State Street
Jackson, Mississippi 39201

WATER WELL DRILLERS LOG

19 JAN 74 — date well completed
19 74 BRYANT WELL CO. — firm name
HARRISON — county well located

LANDOWNER: R. W. BEETER
104 KATHY DR. RT 4.
GULFPORT, MS. 39501
(mailing address)

WELL LOCATION:
sec. 12 T 5 S R 13 W
9 miles NW of SAUCIER
(distance) (direction) (nearest town)

WELL PURPOSE: HOME
(home, irrigation, municipal, industrial)

WELL COMPLETION DATA:

(1) diameter (inches) 2
(2) total depth (feet) 198
(3) static water level (feet) 83 Below top of ground.
(4) casing PVC (material), 188' (depth),
_____ (size) If telescope see back.
(5) screen 10 (length), 188' (depth to top)
2" (size), STAINLESS STEEL (material)
(6) pump 1 (HP) 10 (yield gpm)
ELECTRIC (type power)
(7) electric log NO (yes or no)
_____ (organization running log)
(8) how well bottom plugged BRONZE BACKWASH VALVE

DRILLERS REMARKS: NONE

description of formations encountered	from	to
YELLOW CLAY	0	42
COARSE SAND	42	44
YELLOW CLAY W/SAND STREAKS	44	65
BLUE CLAY	65	109
SHALE	109	174
COARSE SAND	174	198

CODED

JAN 2 ... 19
MISS. BD. OF W...

If well telescopes please sketch and show depths.

GROUND LEVEL

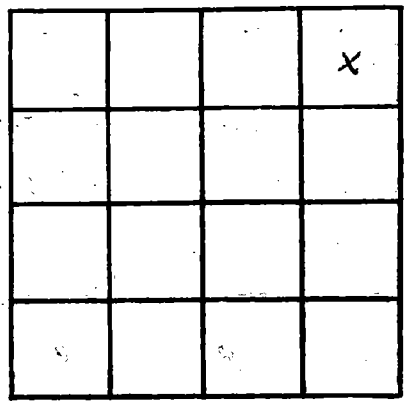

SECTION 12

Please indicate well location X.

ADDITIONAL INFORMATION

If more than one screen, show locations of each on sketch.