HARRISON
A 2021
8/28/81

MISSISSIPPI DEPARTMENT OF NATURAL RESOURCES

Bureau of Land and Water Resources
Southport Mall
P.O. Box 10631
Jackson, Mississippi 39209

WATER WELL DRILLERS LOG

8/28/81 19 — date well completed
Lyman Well Co — firm name
Harrison — county well located

LANDOWNER: Rita M Kemp
Rt 1 Box 309
Saucier, Miss 39574
(mailing address)

WELL LOCATION:
sec. 34 T 5 N (S) R 13 E (W)
4 miles NW of Lizana
(distance) (direction) (nearest town)

WELL PURPOSE: home
(home, irrigation, municipal, industrial)

WELL COMPLETION DATA:
(1) diameter (inches) 2"
(2) total depth (feet) 387'
(3) static water level (feet) 127 below above top of ground.
(4) casing PVC (material), 377' (depth),
2" (size) if telescope see back.
(5) screen 10' (length), 377' (depth to top)
2" (size), PVC (material)
(6) pump 1½ (HP) 10 (yield gpm)
electric (type power)
(7) electric log NO (yes or no)
NO (organization running log)
(8) how well bottom plugged sand seal

DRILLERS REMARKS:

description of formations encountered	from	to
Red Clay Fine Sand	0	60
Blue gray Clay	60	140
Good Sand Red Red	140	160
Fine Sand	160	183
Blue Clay	183	210
Fine Sand	210	230
Blue Clay	230	315
Good Sand	315	377

DEPT OF NATURAL RESOURCES
BUREAU OF LAND & WATER RESOURCES
OCT 20 1981
RECEIVED

If well telescopes please sketch and show depths.

GROUND LEVEL

Red Clay	Fine	0	60
Sand			
Blue Gray Clay		60	140
Good Sand but Red		140	160
Fine Sand		160	183
Blue Clay		183	310
Fine Sand		310	330
Blue Clay		330	371
Good Sand		371	377

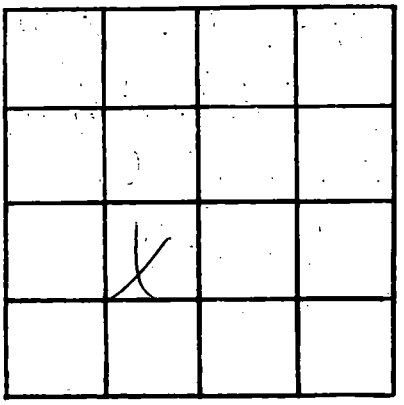

SECTION 34

Please indicate well location X.

ADDITIONAL INFORMATION

If more than one screen, show locations of each on sketch.