MISSISSIPPI DEPARTMENT OF NATURAL RESOURCES

Bureau of Land and Water Resources

P.O. Box 10631
Jackson, Mississippi 39209

WATER WELL DRILLERS LOG

COUNTY WELL LOCATED	Harrison
WELL NUMBER	A 2036
CODED	
DATE WELL COMPLETED	10/20/87
PERMIT NUMBER	
NAME OF DRILLING FIRM	Green Well Co

NAME & MAILING ADDRESS OF LANDOWNER: Camelot Farms, 26269 Hwy 53, Saucier 39674

WELL LOCATION: SEC	TOWNSHIP	RANGE
27	5 N	13 E

DISTANCE	DIRECTION	NEAREST TOWN
15 Miles	North of	Pass Christian

OTHER LANDMARK: None

WELL PURPOSE: Home, Irrigation, Municipal, Industrial, Fish Pond, etc.

PUMP DATA

PUMP TYPE (Circle One): Submersible, Turbine, Jet, Flowing Well, Other (Describe) _____

POWER TYPE (Circle One): Electric, Tractor, Diesel, Gasoline, Butane, Other (Describe) _____

Pump Capacity (GPM)	No. of Stages	Setting Depth
15		180 FT.

PUMP TEST

Well yielded _____ GPM with a drawdown of _____ ft. after _____ hours of pumping

WELL DATA

Well Depth	Casing Diameter (In.)	Casing Length (Ft.)
565'	4x2	565'

Type of Casing	Hole Depth	Depth to Static Water Level
PVC	565'	140'

TYPE OF COMPLETION: (Circle One or More): Gravel Packed, Underreamed, Telescoped, Natural Development, Open Hole, Other (Describe) _____

Top of Lap Pipe or Reduction in Casing: FEET

IF TELESCOPED OR MORE THAN ONE SCREEN: USE BACK PAGE

LOG DATA

TYPE OF LOG RUN (Circle One): No Log Run, Electric, Gamma Ray, Density, Sonic, Neutron, Other (Describe) _____

Name of Organization Running Log

GEOLOGIC DATA (Office Use Only)

Surface Elev.	Geologic Unit	Unit Thickness	Depth to Top
Subs. SWL	Date	Analysis	Aquifer Test

Driller's Remarks: None

SCREEN DATA

Diameter - Inches	Length - Feet	Slot Size - Inches
2"	20'	.006

Screen Type	Depth to Bottom - Feet
PVC sawed slotted	565'

DESCRIPTION OF FORMATIONS ENCOUNTERED	FROM	TO
Topsoil	0	1'
Sandy clay	1'	34
Clay	34'	76'
Sand fine & clay	76'	123'
Clay	123'	322
Clay & sand	322	363
Clay	363	538'
Sand	538'	565'

FORMATIONS (Continued)	FROM	TO

IF MORE SPACE IS NEEDED, USE BACK

RECEIVED
FEB 22 1988
Department of Natural Resources
Bureau of Land & Water Resources

If well telescopes please
sketch and show depths.

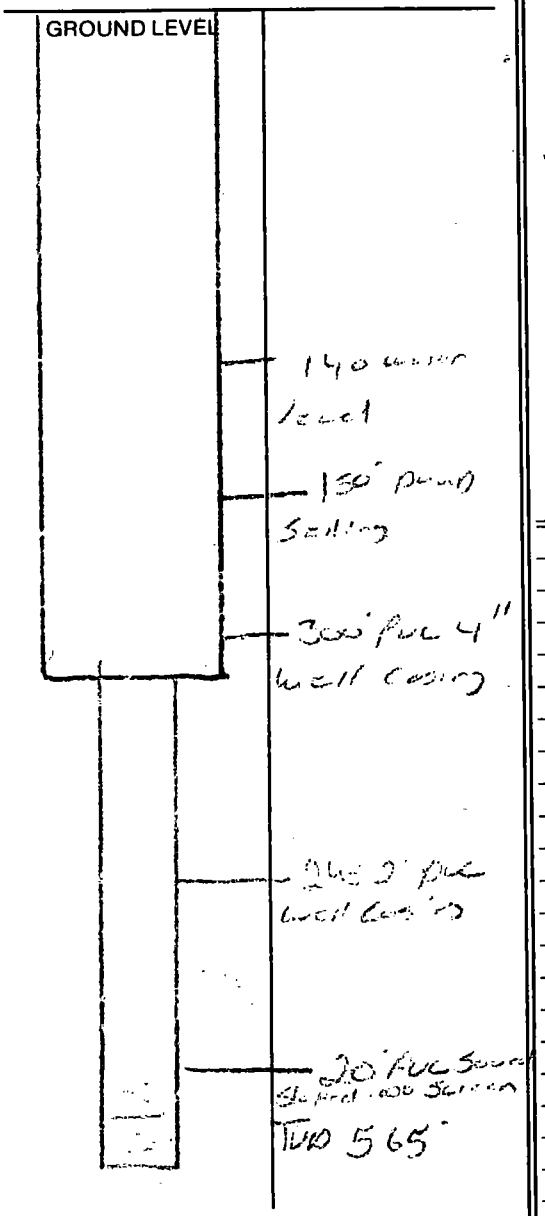

If more than one screen,
show location of each on sketch.

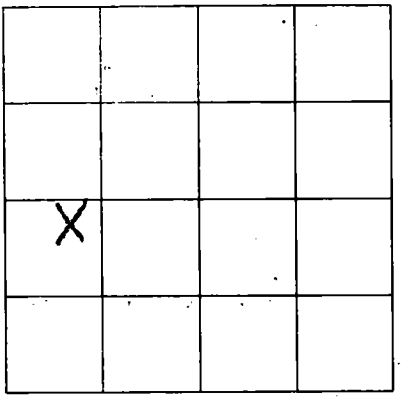

SECTION 27

Please indicate well location X.

ADDITIONAL INFORMATION