MISSISSIPPI DEPARTMENT OF NATURAL RESOURCES

Bureau of Land and Water Resources

P.O. Box 10631
Jackson, Mississippi 39209

WATER WELL DRILLERS LOG

COUNTY WELL LOCATED: Harrison

WELL NUMBER: A 2038 CODED

DATE WELL COMPLETED: 6/02/88

PERMIT NUMBER: 0239

NAME OF DRILLING FIRM: McGill Pump & Wells

NAME & MAILING ADDRESS OF LANDOWNER: Janice Shaw

WELL LOCATION: SEC 20 TOWNSHIP 5 N (S) RANGE 13 E (W)

DISTANCE: 20 Miles DIRECTION: EAST of NEAREST TOWN: Pearlville

OTHER LANDMARK: Hyway 53

WELL PURPOSE: Home, Irrigation, Municipal, Industrial, Fish Pond, etc.

PUMP DATA

PUMP TYPE (Circle One): Submersible, Turbine, (Jet) Flowing Well, Other (Describe) _____

POWER TYPE (Circle One): (Electric), Tractor, Diesel, Gasoline, Butane, Other (Describe) _____

Pump Capacity (GPM)	No. of Stages	Setting Depth
13	2	140' FT.

PUMP TEST

Well yielded 7 GPM with a drawdown of 10 ft. after 1 hours of pumping

WELL DATA

Well Depth	Casing Diameter (In.)	Casing Length (Ft.)
220'	2"	210'

Type of Casing	Hole Depth	Depth to Static Water Level
PVC	220'	110'

TYPE OF COMPLETION: (Circle One or More): Gravel Packed, Underreamed, Telescoped, (Natural Development), Open Hole, Other (Describe) _____

Top of Lap Pipe or Reduction in Casing: FEET

IF TELESCOPED OR MORE THAN ONE SCREEN: USE BACK PAGE

SCREEN DATA

Diameter - Inches	Length - Feet	Slot Size - Inches
2"	10'	.0006

Screen Type	Depth to Bottom - Feet
PVC	220'

LOG DATA

TYPE OF LOG RUN (Circle One): (No Log Run), Electric, Gamma Ray, Density, Sonic, Neutron, Other (Describe) _____

Name of Organization Running Log

GEOLOGIC DATA (Office Use Only)

Surface Elev.	Geologic Unit	Unit Thickness	Depth to Top
Subs. SWL	Date	Analysis	Aquifer Test

Driller's Remarks

DESCRIPTION OF FORMATIONS ENCOUNTERED	FROM	TO
mud	0	40
Sand	40	80
mud	80	200
Sand	200	220

FORMATIONS ENCOUNTERED	FROM	TO

IF MORE SPACE IS NEEDED, USE BACK

RECEIVED
JUN 17 1988
Department of Natural Resources
Bureau of Land & Water Resources

If well telescopes please sketch and show depths.

GROUND LEVEL

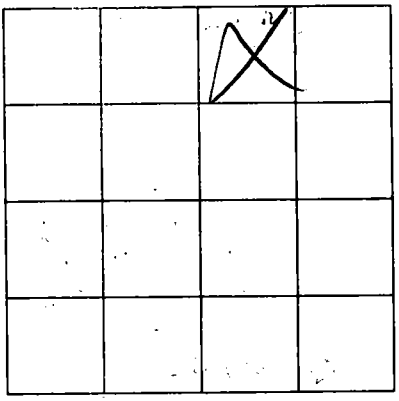

SECTION _____

Please indicate well location X.

ADDITIONAL INFORMATION

If more than one screen, show location of each on sketch.