MISSISSIPPI DEPARTMENT OF NATURAL RESOURCES

Bureau of Land and Water Resources

P.O. Box 10631
Jackson, Mississippi 39209

WATER WELL DRILLERS LOG

COUNTY WELL LOCATED: Harrison	PERMIT NUMBER: 0239
WELL NUMBER: A 2641	CODED:
	NAME OF DRILLING FIRM: McGill Pump & Well
DATE WELL COMPLETED: Oct. 13-89	

NAME & MAILING ADDRESS OF LANDOWNER: Jerry Northrup

WELL LOCATION: SEC 34 TOWNSHIP 5 N (S) RANGE 13 E (W)

DISTANCE 2 Miles DIRECTION North of NEAREST TOWN Lyons

OTHER LANDMARK

WELL PURPOSE: (Home), Irrigation, Municipal, Industrial, Fish Pond, etc.

PUMP DATA

PUMP TYPE (Circle One): Submersible, Turbine, (Jet), Flowing Well, Other (Describe)

POWER TYPE (Circle One): (Electric), Tractor, Diesel, Gasoline, Butane, Other (Describe) H/P

Pump Capacity (GPM)	No. of Stages	Setting Depth
7	2	130' FT.

PUMP TEST

Well yielded 7 GPM with a drawdown of 5 ft. after 1 hours of pumping

WELL DATA

Well Depth	Casing Diameter (In.)	Casing Length (Ft.)
220'	2"	20'

Type of Casing	Hole Depth	Depth to Static Water Level
PVC	220'	110'

TYPE OF COMPLETION: (Circle One or More): Gravel Packed, Underreamed, Telescoped, (Natural Development), Open Hole, Other (Describe)

Top of Lap Pipe or Reduction in Casing FEET

IF TELESCOPED OR MORE THAN ONE SCREEN: USE BACK PAGE

SCREEN DATA

Diameter - Inches	Length - Feet	Slot Size - Inches
2"	10'	.0006

Screen Type	Depth to Bottom - Feet
PVC	220'

LOG DATA

TYPE OF LOG RUN (Circle One): (No Log Run), Electric, Gamma Ray, Density, Sonic, Neutron, Other (Describe)

Name of Organization Running Log

GEOLOGIC DATA (Office Use Only)

Surface Elev.	Geologic Unit	Unit Thickness	Depth to Top
Subs. SWL	Date	Analysis	Aquifer Test

Driller's Remarks

DESCRIPTION OF FORMATIONS ENCOUNTERED	FROM	TO	FORMATIONS (Continued)	FROM	TO
mud	0	170			
sand	170	220			

RECEIVED
AUG 16 1990
Department of Natural Resources
Bureau of Land & Water Resources

IF MORE SPACE IS NEEDED, USE BACK

If well telescopes please
sketch and show depths.

GROUND LEVEL

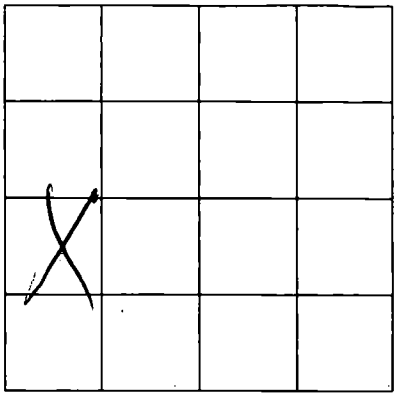

SECTION _____

Please indicate well location X.

ADDITIONAL INFORMATION

If more than one screen,
show location of each on sketch.