MISSISSIPPI DEPARTMENT OF ENVIRONMENTAL QUALITY
Office of Land and Water Resources

P. O. Box 10631
Jackson, MS 39289-0631

WATER WELL DRILLERS LOG

COUNTY WELL LOCATED: Harrison	
WELL NUMBER: A-2047	CODED:
DATE WELL COMPLETED: 8-20-99	
PERMIT NUMBER: 0-239	
NAME OF DRILLING FIRM: mc Gill Pump + well	

NAME & MAILING ADDRESS OF LANDOWNER
David Hardy
Dancia advance Rd
Dancia MS

WELL LOCATION: SEC 12 (13) TOWNSHIP 5 N S RANGE 13 E W

DISTANCE ____ Miles DIRECTION ____ of NEAREST TOWN ____

OTHER LANDMARK

WELL PURPOSE: (Home) Irrigation, Municipal, Industrial, Fish Pond, etc.

PUMP DATA

PUMP TYPE (Circle One): Submersible, Turbine, (Jet) Flowing Well, Other (Describe) ____

POWER TYPE (Circle One): (Electric) Tractor, Diesel, Gasoline, Butane, Other (Describe) ____ H/P 1

Pump Capacity (GPM)	No. of Stages	Setting Depth
10	2	80 FT.

PUMP TEST

Well yielded 10 GPM with a drawdown of 5 ft. after 5 hours of pumping

WELL DATA

Well Depth	Casing Diameter (In.)	Casing Length (Ft.)
280	2"	260

Type of Casing	Hole Depth	Depth to Static Water Level
pvc	280	60

TYPE OF COMPLETION: (Circle One or More): Gravel Packed, Underreamed, Telescoped, (Natural Development), Open Hole, Other (Describe) ____

WELL GROUTED TO A DEPTH OF 10 FEET
Type Grout (circle one): Cement, Bentonite, or Mix

LOG DATA

TYPE OF LOG RUN (Circle One): No Log Run, Electric, Gamma Ray, Density, Sonic, Neutron, Other (Describe) Hand written

Name of Organization Running Log

GEOLOGIC DATA (Office Use Only)

Surface Elev.	Geologic Unit	Unit Thickness	Depth to Top
Subs. SWL	Date	Analysis	Aquifer Test

Driller's Remarks

Top of Lap Pipe or Reduction in Casing ____ FEET

IF TELESCOPED OR MORE THAN ONE SCREEN: USE BACK PAGE

SCREEN DATA

Diameter - Inches	Length - Feet	Slot Size - Inches
2"	20	.006

Screen Type	Depth to Bottom - Feet
pvc	280

DESCRIPTION OF FORMATIONS ENCOUNTERED	FROM	TO
Sand	0	40
mud	40	160
sand	160	180
mud	180	240
Sand	240	280

FORMATIONS (Continued)	FROM	TO

IF MORE SPACE IS NEEDED, USE BACK

REC'D JUN 25 2001

If well telescopes please
sketch and show depths.

GROUND LEVEL

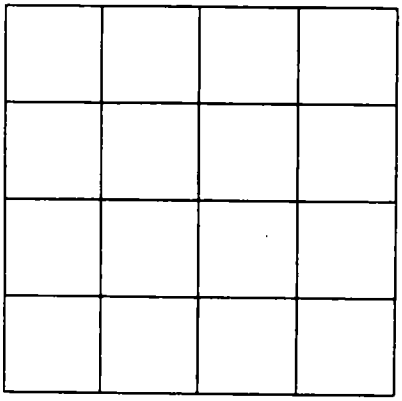

SECTION _____

Please indicate well location X.

ADDITIONAL INFORMATION

If more than one screen,
show location of each on sketch.