Harrison
B23
6-67

MISSISSIPPI
BOARD OF WATER COMMISSIONERS
416 North State Street
Jackson, Mississippi 39201

CODED

WATER WELL DRILLERS LOG

Dec 24 1967 M&B Drilling Co. Harrison
date well completed — firm name — county well located

LANDOWNER: William Smith
Rt. 1 Saucier, Miss.
(mailing address)

WELL LOCATION:
sec. 14 T 5 S R 12 W
1½ miles SW of Saucier
(distance) (direction) (nearest town)

WELL PURPOSE: Home, Farm
(home, irrigation, municipal, industrial)

WELL COMPLETION DATA:
(1) diameter (inches) 2"
(2) total depth (feet) 350
(3) static water level (feet) 82 below above top of ground.
(4) casing PVC (material), 344 (depth), 2" (size) If telescope see back.
(5) screen 6ft (length), 344 (depth to top), 2" (size), PVC Sand Pac (material)
(6) pump 1 (HP) 8 (yield gpm)
220 Vol 1 ϕ (type power)
(7) electric log No (yes or no)
(organization running log)
(8) how well bottom plugged PVC Cap

DRILLERS REMARKS:

description of formations encountered	from	to
Surface	0	10
Red Clay	10	23
White Clay	23	75
Brown Clay	75	85
Dark Grey Clay	85	102
Sand	102	107
Blue Clay	107	180
Sand & Clay Breaks	180	190
Blue Clay	190	197
Sand	197	203
Blue Clay	203	213
Sand	213	215
Blue Clay	215	300
Coarse Grey Sand	300	350
Still Cutting Sand		
When Drilling Stopped		

CODED

NOV 3 1967 MISS. WATER COMM.

If well telescopes please sketch and show depths.

GROUND LEVEL

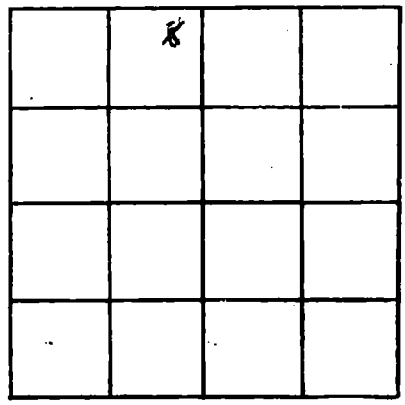

SECTION 14

Please indicate well location X.

ADDITIONAL INFORMATION

If more than one screen, show locations of each on sketch.