Harrison
B 60
8-29-73

MISSISSIPPI
BOARD OF WATER COMMISSIONERS
416 North State Street
Jackson, Mississippi 39201

CODED

WATER WELL DRILLERS LOG

8-29-73 19 — date well completed
R. T Moore — firm name
HARRISON — county well located

LANDOWNER: Larry Walker
Yanicee Town Rd Rt #1
Saucier, Miss
(mailing address)

WELL LOCATION:
sec. 10 T 5 N (S) R 12 E (W)
2 1/2 miles SW of Saucier
(distance) (direction) (nearest town)

WELL PURPOSE:
(home, irrigation, municipal, industrial)

WELL COMPLETION DATA:

(1) diameter (inches) 8"
(2) total depth (feet) 230'
(3) static water level (feet) 4' below above top of ground.
(4) casing PVC (material), 220 (depth), ____ (size) if telescope see back.
(5) screen 10' (length), 220' (depth to top)
8" (size), SS (material)
(6) pump 1 (HP) 10 (yield gpm)
E (type power)
(7) electric log ____ (yes or no)
____ (organization running log)
(8) how well bottom plugged Bottom

DRILLERS REMARKS:

description of formations encountered	from	to
Topsoil	0	10
White Sand	10	20
White Clay	20	70
Blue Clay	70	200
Gray Sand	200	230

CODED

SEP 10 1973

If well telescopes please sketch and show depths.

GROUND LEVEL

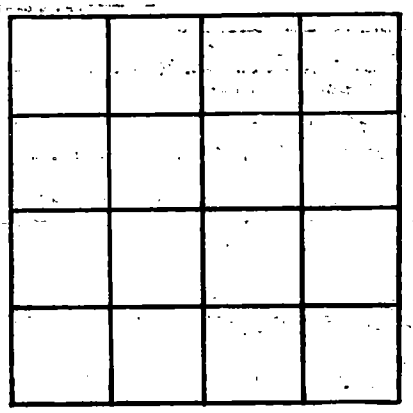

SECTION _____

Please indicate well location X.

ADDITIONAL INFORMATION

If more than one screen, show locations of each on sketch.