Harrison
B 69
9-9-74

MISSISSIPPI
BOARD OF WATER COMMISSIONERS
416 North State Street
Jackson, Mississippi 39201

CODED

WATER WELL DRILLERS LOG

Sept. 9 1974 — date well completed
Ladnier's Well Work's — firm name
Harrison — county well located

LANDOWNER: Daniel Cussin
off Saucier & Lizana Rd
Saucier, MS
(mailing address)

WELL LOCATION:
sec. 4 T 5 S R 12 W
3 miles SW of Saucier
(distance) (direction) (nearest town)

WELL PURPOSE: home
(home, irrigation, municipal, industrial)

WELL COMPLETION DATA:

(1) diameter (inches) 2 in.
(2) total depth (feet) 315
(3) static water level (feet) 65 below ~~above~~ top of ground.
(4) casing GALV. (material), 305 (depth),
2in (size) If telescope see back.
(5) screen 10 ft (length), 305 (depth to top)
2in (size), SSteel (material)
(6) pump 1 (HP) 7 (yield gpm)
elec. (type power)
(7) electric log NO (yes or no)
(organization running log)
(8) how well bottom plugged ball check

DRILLERS REMARKS:

description of formations encountered	from	to
yellow ~~[illegible]~~ clay	0	90
yellow sand	90	95
yellow clay	95	180
blue clay	180	290
blue sand	290	315

RECEIVED
NOV - 4 1974
MISS. BD. OF WATER COMM.

If well telescopes please sketch and show depths.

GROUND LEVEL

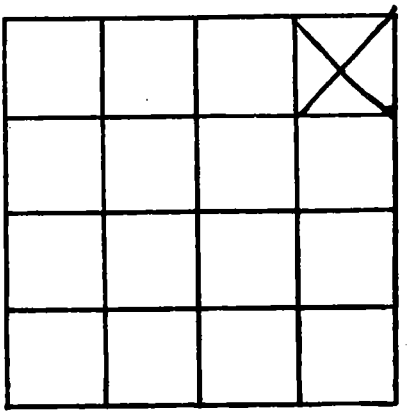

SECTION 4

Please indicate well location X.

ADDITIONAL INFORMATION

If more than one screen, show locations of each on sketch.