HARRISON

B 93

11-18-78

MISSISSIPPI BOARD OF WATER COMMISSIONERS
416 North State Street
Jackson, Mississippi 39201

CODED

WATER WELL DRILLERS LOG

Nov. 18 1978 Duncan Well Drilling Harrison
date well completed — firm name — county well located

LANDOWNER: Otis Scarborough
1233 Joseph Ave
Gulfport Ms. 39501
(mailing address)

WELL LOCATION: ES
sec. 33 T ~~5~~ N (S) R 12 E (W) ?
5 miles ~~N~~ SE of Saucier
(distance) (direction) (nearest town)

WELL PURPOSE: Home
(home, irrigation, municipal, industrial)

WELL COMPLETION DATA:

(1) diameter (inches) 2"

(2) total depth (feet) 336'

(3) static water level (feet) 46 below above top of ground.

(4) casing PVC, 326,
(material), (depth)
—
(size) if telescope see back.

(5) screen 10', 326
(length), (depth to top)
2", PVC
(size), (material)

(6) pump 1 10
(HP) (yield gpm)
electric
(type power)

(7) electric log —
(yes or no)
—
(organization running log)

(8) how well bottom plugged Sand
Shale

DRILLERS REMARKS:

description of formations encountered	from	to
Clay	0	25
Sand	25	60
Blue Clay	60	280
Fine Sand	280	310
Coarse Sand	310	336

CODED

RECEIVED
JAN 10 1978
BOARD OF WATER COMM.

If well telescopes please sketch and show depths.

GROUND LEVEL

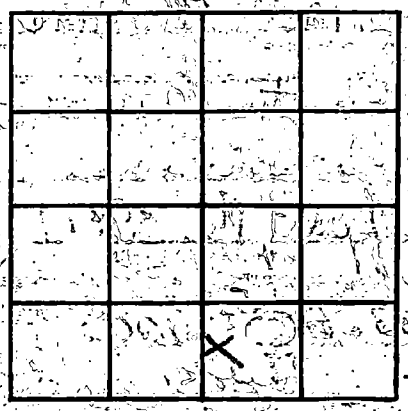

SECTION 33

Please indicate well location X:

ADDITIONAL INFORMATION

If more than one screen, show locations of each on sketch.