HARRISON

B 99

11-9-78

MISSISSIPPI
BOARD OF WATER COMMISSIONERS
416 North State Street
Jackson, Mississippi 39201

CODED

WATER WELL DRILLERS LOG

11/9 (date well completed) 19 78 Lyman Well Co. (firm name) Harrison (county well located)

LANDOWNER: Ellis
Yankee Town Road
Lauren, Md
(mailing address)

WELL LOCATION:
sec 25 T 5 N (S) R 12 E (W)
20 (distance) miles N (direction) of Gulfport (nearest town)

WELL PURPOSE: Home
(home, irrigation, municipal, industrial)

WELL COMPLETION DATA:

(1) diameter (inches) 2"

(2) total depth (feet) 320

(3) static water level (feet) 1 ft below (above) top of ground.

(4) casing PVC (material), 310 (depth),
_____ (size) if telescope see back.

(5) screen 10' (length), 310 (depth to top)
8 slot (size), PVC (material)

(6) pump NA (HP) NA (yield gpm)
NA (type power)

(7) electric log no (yes or no)
_____ (organization running log)

(8) how well bottom plugged Sand Shaft

DRILLERS REMARKS:

description of formations encountered	from	to
Yellow Clay	0	8
White Sand	8	13
Blue & Gray Clay	13	53
Yellow Mud (Quick Sand)	53	260
Salt & pepper sand	260	320

CODED

RECEIVED
NOV 28 1978
MISS. BD. OF WATER COMM.

If well telescopes please sketch and show depths.

GROUND LEVEL

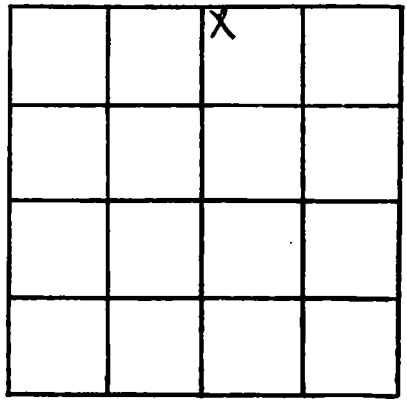

SECTION 25

Please indicate well location X.

ADDITIONAL INFORMATION

If more than one screen, show locations of each on sketch.