MISSISSIPPI DEPARTMENT OF NATURAL RESOURCES

Bureau of Land and Water Resources

P.O. Box 10631
Jackson, Mississippi 39209

WATER WELL DRILLERS LOG

COUNTY WELL LOCATED: Harrison	
WELL NUMBER: B 292	CODED
DATE WELL COMPLETED: 4-12-89	
PERMIT NUMBER: O-493	
NAME OF DRILLING FIRM: Bailey Beck's Well Works	

NAME & MAILING ADDRESS OF LANDOWNER
Arthur J. Stone
21240 Harris Rd.
Saucier Ms. 39574

WELL LOCATION: SEC 24 TOWNSHIP 5-S N/S RANGE 12 E/(W)

DISTANCE _____ Miles DIRECTION _____ of NEAREST TOWN _____

OTHER LANDMARK

WELL PURPOSE: (Home) Irrigation, Municipal, Industrial, Fish Pond, etc.

PUMP DATA

PUMP TYPE (Circle One): Submersible, Turbine, Jet, Flowing Well, Other (Describe) 1 hp 2 Stage

POWER TYPE (Circle One): (Electric) Tractor, Diesel, Gasoline, Butane, Other (Describe) _____

Pump Capacity (GPM)	No. of Stages	Setting Depth
1	2	68 FT.

PUMP TEST

Well yielded _____ GPM with a drawdown of _____ ft. after _____ hours of pumping

WELL DATA

Well Depth	Casing Diameter (In.)	Casing Length (Ft.)
205	2"	20 ft

Type of Casing	Hole Depth	Depth to Static Water Level
PVC.	2"	38 ft.

TYPE OF COMPLETION: (Circle One or More) Gravel Packed, Underreamed, Telescoped, (Natural Development) Open Hole, Other (Describe) _____

Top of Lap Pipe or Reduction in Casing FEET

IF TELESCOPED OR MORE THAN ONE SCREEN: USE BACK PAGE

LOG DATA

TYPE OF LOG RUN (Circle One): No Log Run, Electric, Gamma Ray, Density, Sonic, Neutron, Other (Describe) _____

Name of Organization Running Log: Bailey Beck's Well Works

GEOLOGIC DATA (Office Use Only)

Surface Elev.	Geologic Unit	Unit Thickness	Depth to Top
Subs. SWL	Date	Analysis	Aquifer Test

Driller's Remarks

SCREEN DATA

Diameter - Inches	Length - Feet	Slot Size - Inches
2"	20 ft.	#8

Screen Type	Depth to Bottom - Feet
Johnson Screen	205

DESCRIPTION OF FORMATIONS ENCOUNTERED	FROM	TO

DESCRIPTION OF FORMATIONS ENCOUNTERED	FROM	TO

RECEIVED
MAY 15 1990
Department of Natural Resources
Bureau of Land & Water Resources

IF MORE SPACE IS NEEDED, USE BACK

If well telescopes please
sketch and show depths.

GROUND LEVEL

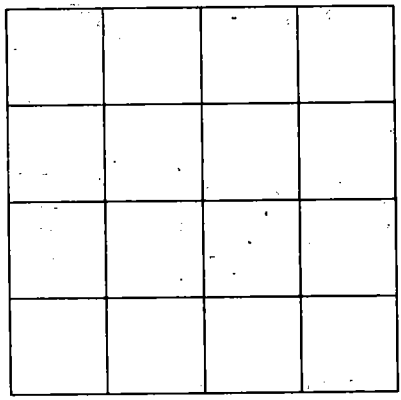

SECTION _____

Please indicate well location X.

ADDITIONAL INFORMATION

If more than one screen,
show location of each on sketch.