MISSISSIPPI DEPARTMENT OF NATURAL RESOURCES

Bureau of Land and Water Resources

P.O. Box 10631
Jackson, Mississippi 39209

WATER WELL DRILLERS LOG

COUNTY WELL LOCATED: Harrison	PERMIT NUMBER: 0239
WELL NUMBER: B 2096 CODED	NAME OF DRILLING FIRM: McGill Pump & Well
DATE WELL COMPLETED: 12/4/90	

NAME & MAILING ADDRESS OF LANDOWNER
Waymon Parker
19300 Wortham Rd.
Saucier MS. 39574

WELL LOCATION: SEC 31 TOWNSHIP 5 N (S) RANGE 12 E (W)

DISTANCE 3 Miles DIRECTION North of NEAREST TOWN Lizana

OTHER LANDMARK: Saucier/Lizana Rd.

WELL PURPOSE: (Home) Irrigation, Municipal, Industrial, Fish Pond, etc.

PUMP DATA

PUMP TYPE (Circle One): Submersible, Turbine, (Jet) Flowing Well, Other (Describe) _____

POWER TYPE (Circle One): (Electric) Tractor, Diesel, Gasoline, Butane, Other (Describe) _____ H/P _____

Pump Capacity (GPM)	No. of Stages	Setting Depth
12	2	90' FT.

PUMP TEST

Well yielded 9 GPM with a drawdown of 8 ft. after 1 hours of pumping

WELL DATA

Well Depth	Casing Diameter (In.)	Casing Length (Ft.)
200'	2"	20'
Type of Casing	**Hole Depth**	**Depth to Static Water Level**
PVC	200'	70'

TYPE OF COMPLETION: (Circle One or More): Gravel Packed, Underreamed, Telescoped, (Natural Development), Open Hole, Other (Describe) _____

Top of Lap Pipe or Reduction in Casing FEET

IF TELESCOPED OR MORE THAN ONE SCREEN: USE BACK PAGE

LOG DATA

TYPE OF LOG RUN (Circle One): Electric, Gamma Ray, Density, Sonic, Neutron, (No Log Run) Other (Describe) _____

Name of Organization Running Log

GEOLOGIC DATA (Office Use Only)

Surface Elev.	Geologic Unit	Unit Thickness	Depth to Top
Subs. SWL	Date	Analysis	Aquifer Test

Driller's Remarks

SCREEN DATA

Diameter - Inches	Length - Feet	Slot Size - Inches
2"	10'	.0006
Screen Type		**Depth to Bottom - Feet**
PVC		200'

DESCRIPTION OF FORMATIONS ENCOUNTERED	FROM	TO
Mud	0	30
Sand	30	50
Mud	50	175
Sand	175	200

FORMATIONS (Continued)	FROM	TO

RECEIVED
SEP 23 1991
Dept. of Environmental Quality
Bureau of Land & Water Resources

IF MORE SPACE IS NEEDED, USE BACK

If well telescopes please
sketch and show depths.

GROUND LEVEL

If more than one screen,
show location of each on sketch.

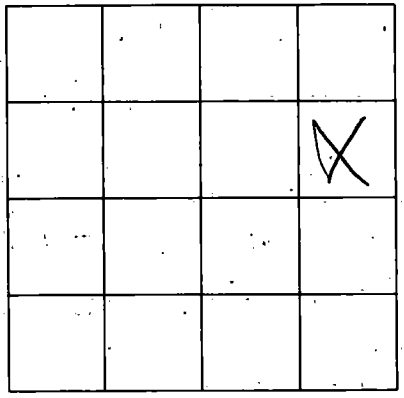

SECTION _____

Please indicate well location X.

ADDITIONAL INFORMATION