MISSISSIPPI DEPARTMENT OF ENVIRONMENTAL QUALITY
Bureau of Land and Water Resources

P. O. Box 10631
Jackson, MS 39289-0631
WATER WELL DRILLERS LOG

COUNTY WELL LOCATED: Hancock	
WELL NUMBER: B2103	CODED:
DATE WELL COMPLETED: 10-9-92	
PERMIT NUMBER: C-029	
NAME OF DRILLING FIRM: McGill	

NAME & MAILING ADDRESS OF LANDOWNER: Clinton Shaw, 5341 Hwy 53

WELL LOCATION: SEC 4 TOWNSHIP 5 N/S RANGE 12 E/W

DISTANCE ____ Miles DIRECTION ____ of NEAREST TOWN ____

OTHER LANDMARK

WELL PURPOSE: (Home) Irrigation, Municipal, Industrial, Fish Pond, etc.

PUMP DATA

PUMP TYPE (Circle One): Submersible, Turbine, Jet, Flowing Well, Other (Describe) ____

POWER TYPE (Circle One): Electric, Tractor, Diesel, Gasoline, Butane, Other (Describe) ____ H/P ____

Pump Capacity (GPM)	No. of Stages	Setting Depth
15	2	60 FT.

PUMP TEST

Well yielded 10 GPM with a drawdown of ____ ft. after 1 hours of pumping

WELL DATA

Well Depth	Casing Diameter (In.)	Casing Length (Ft.)
410	2	20
Type of Casing	**Hole Depth**	**Depth to Static Water Level**
PVC	410	40

TYPE OF COMPLETION: (Circle One or More): Gravel Packed, Underreamed, Telescoped, (Natural Development), Open Hole, Other (Describe) ____

Top of Lap Pipe or Reduction in Casing ____ FEET

IF TELESCOPED OR MORE THAN ONE SCREEN: USE BACK PAGE

LOG DATA

TYPE OF LOG RUN (Circle One): (No Log Run), Electric, Gamma Ray, Density, Sonic, Neutron, Other (Describe) ____

Name of Organization Running Log

SCREEN DATA

Diameter - Inches	Length - Feet	Slot Size - Inches
2	10	0006
Screen Type	**Depth to Bottom - Feet**	
PVC	400	

GEOLOGIC DATA (Office Use Only)

Surface Elev.	Geologic Unit	Unit Thickness	Depth to Top
Subs. SWL	Date	Analysis	Aquifer Test

Driller's Remarks

DESCRIPTION OF FORMATIONS ENCOUNTERED	FROM	TO	FORMATIONS (Continued)	FROM	TO
			IF MORE SPACE IS NEEDED, USE BACK		

RECEIVED
OCT 07 1992
Dept. of Environmental Quality
Bureau of Land & Water Resources

If well telescopes please
sketch and show depths.

GROUND LEVEL

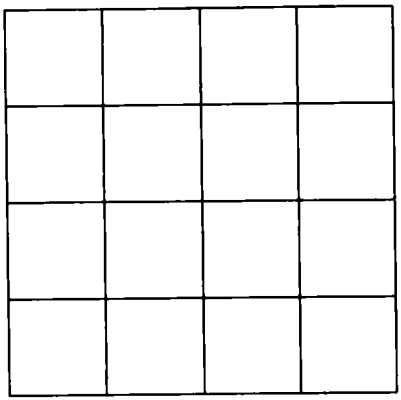

SECTION _____

Please indicate well location X.

ADDITIONAL INFORMATION

If more than one screen,
show location of each on sketch.