MISSISSIPPI DEPARTMENT OF NATURAL RESOURCES

Bureau of Land and Water Resources

P.O. Box 10631
Jackson, Mississippi 39209
WATER WELL DRILLERS LOG

COUNTY WELL LOCATED	Harrison
WELL NUMBER / CODED	B 2110
DATE WELL COMPLETED	4-7-89
PERMIT NUMBER	
NAME OF DRILLING FIRM	M&B Drilling Co.
	Braden Pump & Well Ser.

NAME & MAILING ADDRESS OF LANDOWNER: George Sims, P.O. Box 74, Saucier Miss.

WELL LOCATION: SEC 24 TOWNSHIP 5 S RANGE 12 W

DISTANCE 2 Miles DIRECTION S of NEAREST TOWN Saucier

OTHER LANDMARK:

WELL PURPOSE: Home, Irrigation, Municipal, Industrial, Fish Pond, etc.: Home

PUMP DATA

PUMP TYPE (Circle One): Submersible, Turbine, Jet, Flowing Well, Other (Describe) _____

POWER TYPE (Circle One): Electric, Tractor, Diesel, Gasoline, Butane, Other (Describe) _____ H/P _____

Pump Capacity (GPM)	No. of Stages	Setting Depth
10	2	60 FT.

PUMP TEST

Well yielded _____ GPM with a drawdown of _____ ft. after _____ hours of pumping

WELL DATA

Well Depth	Casing Diameter (In.)	Casing Length (Ft.)
165	2"	150
Type of Casing	**Hole Depth**	**Depth to Static Water Level**
PVC	165	38'

TYPE OF COMPLETION: (Circle One or More): Gravel Packed, Underreamed, Telescoped, Natural Development, Open Hole, Other (Describe) _____

Top of Lap Pipe or Reduction in Casing FEET

IF TELESCOPED OR MORE THAN ONE SCREEN: USE BACK PAGE

LOG DATA

TYPE OF LOG RUN (Circle One): No Log Run, Electric, Gamma Ray, Density, Sonic, Neutron, Other (Describe) _____

Name of Organization Running Log

GEOLOGIC DATA (Office Use Only)

Surface Elev.	Geologic Unit	Unit Thickness	Depth to Top
Subs. SWL	Date	Analysis	Aquifer Test

Driller's Remarks

SCREEN DATA

Diameter - Inches	Length - Feet	Slot Size - Inches
2"	10	.008
Screen Type		**Depth to Bottom - Feet**
PVC WOP		160

DESCRIPTION OF FORMATIONS ENCOUNTERED	FROM	TO
Surface Clay	0	14
Red Sand	14	30
Blue Clay	30	140
Brown Sand	140	160
Blue Clay	160	165 +

FORMATIONS (Continued)	FROM	TO

IF MORE SPACE IS NEEDED, USE BACK

RECEIVED
APR 21 1989
Dept. of Natural Resources
Bureau of Land & Water Resources

If well telescopes please sketch and show depths.

GROUND LEVEL

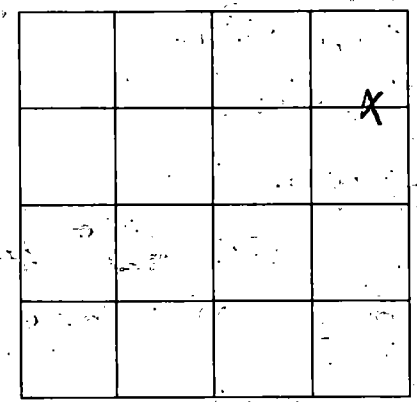

SECTION 24

Please indicate well location X.

ADDITIONAL INFORMATION

If more than one screen, show location of each on sketch.