MISSISSIPPI DEPARTMENT OF ENVIRONMENTAL QUALITY
Office of Land and Water Resources

P. O. Box 10631
Jackson, MS 39289-0631

WATER WELL DRILLERS LOG

COUNTY WELL LOCATED: Harrison	PERMIT NUMBER: 0239
WELL NUMBER: B 2122 CODED	NAME OF DRILLING FIRM: McGill Pump & Well
DATE WELL COMPLETED	

NAME & MAILING ADDRESS OF LANDOWNER: WILLIAM TINKER

WELL LOCATION: SEC 35 TOWNSHIP 4 N/S RANGE 12 E/W

DISTANCE: 4 Miles DIRECTION: North of NEAREST TOWN: Saucier

OTHER LANDMARK:

WELL PURPOSE: Home, Irrigation, Municipal, Industrial, Fish Pond, etc.

PUMP DATA

PUMP TYPE (Circle One): Submersible, Turbine, Jet, Flowing Well, Other (Describe) _____

POWER TYPE (Circle One): Electric, Tractor, Diesel, Gasoline, Butane, Other (Describe) _____ H/P _____

Pump Capacity (GPM)	No. of Stages	Setting Depth
		FT.

PUMP TEST

Well yielded _____ GPM with a drawdown of _____ ft. after _____ hours of pumping

WELL DATA

Well Depth	Casing Diameter (In.)	Casing Length (Ft.)
280'	2"	270'

Type of Casing	Hole Depth	Depth to Static Water Level
PVC	280'	

TYPE OF COMPLETION: (Circle One or More): Gravel Packed, Underreamed, Telescoped, Natural Development, Open Hole, Other (Describe) _____

WELL GROUTED TO A DEPTH OF 10 FEET
Type Grout (circle one): Cement, Bentonite, or Mix

LOG DATA

TYPE OF LOG RUN (Circle One): No Log Run, Electric, Gamma Ray, Density, Sonic, Neutron, Other (Describe) _____

Name of Organization Running Log

GEOLOGIC DATA (Office Use Only)

Surface Elev.	Geologic Unit	Unit Thickness	Depth to Top
Subs. SWL	Date	Analysis	Aquifer Test

Driller's Remarks

Top of Lap Pipe or Reduction in Casing: FEET

IF TELESCOPED OR MORE THAN ONE SCREEN: USE BACK PAGE

SCREEN DATA

Diameter - Inches	Length - Feet	Slot Size - Inches
2"	10'	.006

Screen Type	Depth to Bottom - Feet
PVC	270'

DESCRIPTION OF FORMATIONS ENCOUNTERED	FROM	TO
mud & sand	2	80
mud	80	240
sand	240	270

FORMATIONS (Continued)	FROM	TO

IF MORE SPACE IS NEEDED USE BACK

RECEIVED
APR 10 1995
Dept. of Environmental Quality
Office of Land & Water Resources

If well telescopes please sketch and show depths.

GROUND LEVEL

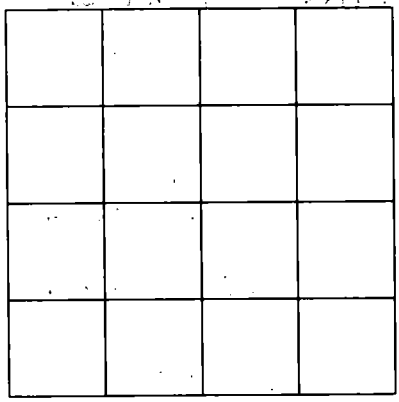

SECTION _____

Please indicate well location X:

ADDITIONAL INFORMATION

If more than one screen, show location of each on sketch.