MISSISSIPPI DEPARTMENT OF ENVIRONMENTAL QUALITY
Office of Land and Water Resources

P. O. Box 10631
Jackson, MS 39289-0631

WATER WELL DRILLERS LOG

COUNTY WELL LOCATED: HARRISON	
WELL NUMBER: B 228	CODED:
DATE WELL COMPLETED: 9-13-95	
PERMIT NUMBER: 0404	
NAME OF DRILLING FIRM: Lyman Well Co. Gulfport Ms.	

NAME & MAILING ADDRESS OF LANDOWNER:
Richard Ritzer
21302 Owen Ladner Rd
Saucier Ms. 39574

WELL LOCATION	SEC	TOWNSHIP	RANGE
	19	5 N (S)	12 E (W)

DISTANCE	DIRECTION	NEAREST TOWN
Miles	of	

OTHER LANDMARK:

WELL PURPOSE: Home, Irrigation, Municipal, Industrial, Fish Pond, etc.

PUMP DATA

PUMP TYPE (Circle One): Submersible, Turbine, (Jet) Flowing Well, Other (Describe) _____

POWER TYPE (Circle One): (Electric) Tractor, Diesel, Gasoline, Butane, Other (Describe) _____ H/P 1

Pump Capacity (GPM)	No. of Stages	Setting Depth
		60' FT.

PUMP TEST

Well yielded _____ GPM with a drawdown of _____ ft. after _____ hours of pumping

WELL DATA

Well Depth	Casing Diameter (In.)	Casing Length (Ft.)
135'	2"	125'

Type of Casing	Hole Depth	Depth to Static Water Level
PVC		39'

TYPE OF COMPLETION: (Circle One or More): Gravel Packed, Underreamed, Telescoped, Natural Development, Open Hole, Other (Describe) _____

WELL GROUTED TO A DEPTH OF _____ FEET
Type Grout (circle one): Cement, Bentonite, or Mix

LOG DATA

TYPE OF LOG RUN (Circle One): (No Log Run) Electric, Gamma Ray, Density, Sonic, Neutron, Other (Describe) _____

Name of Organization Running Log

GEOLOGIC DATA (Office Use Only)

Surface Elev.	Geologic Unit	Unit Thickness	Depth to Top
Subs. SWL	Date	Analysis	Aquifer Test

Driller's Remarks

SCREEN DATA

Diameter - Inches	Length - Feet	Slot Size - Inches
2"	10'	

Screen Type	Depth to Bottom - Feet
PVC	

Top of Lap Pipe or Reduction in Casing

FEET

IF TELESCOPED OR MORE THAN ONE SCREEN: USE BACK PAGE

DESCRIPTION OF FORMATIONS ENCOUNTERED	FROM	TO

FORMATIONS (Continued)	FROM	TO
IF MORE SPACE IS NEEDED, USE BACK		

RECEIVED
OCT 18 1995
Dept. of Environmental Quality
Office of Land & Water Resources

If well telescopes please
sketch and show depths.

GROUND LEVEL

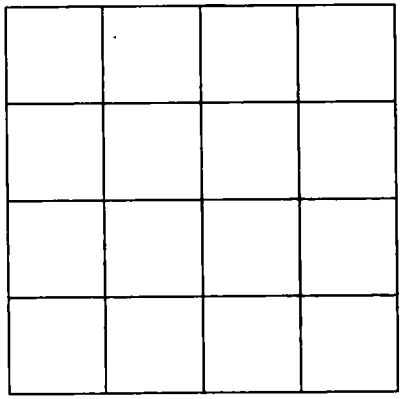

SECTION _____

Please indicate well location X.

ADDITIONAL INFORMATION

If more than one screen,
show location of each on sketch.