MISSISSIPPI DEPARTMENT OF ENVIRONMENTAL QUALITY
Office of Land and Water Resources

P. O. Box 10631
Jackson, MS 39289-0631
WATER WELL DRILLERS LOG

COUNTY WELL LOCATED: Harrison
WELL NUMBER: B 2132 CODED
DATE WELL COMPLETED: Oct. 17-95

PERMIT NUMBER: 0239
NAME OF DRILLING FIRM: McGill Pump & Well

NAME & MAILING ADDRESS OF LANDOWNER:
Sandra Rodrigue
Lot #1 Worthamrd
Gpt MS.

WELL LOCATION: SEC 36 TOWNSHIP 5 N (S) RANGE 12 E (W)

DISTANCE: 3 Miles DIRECTION: South NEAREST TOWN: Saucier

OTHER LANDMARK:

WELL PURPOSE: (Home) Irrigation, Municipal, Industrial, Fish Pond, etc.

PUMP DATA

PUMP TYPE (Circle One): Submersible, Turbine, Jet, Flowing Well, Other (Describe) _____

POWER TYPE (Circle One): Electric, Tractor, Diesel, Gasoline, Butane, Other (Describe) _____ H/P _____

Pump Capacity (GPM)	No. of Stages	Setting Depth
		FT.

PUMP TEST: Well yielded _____ GPM with a drawdown of _____ ft. after _____ hours of pumping

No Pump

WELL DATA

Well Depth	Casing Diameter (In.)	Casing Length (Ft.)
380'	2"	360'

Type of Casing	Hole Depth	Depth to Static Water Level
PVC	380'	60'

TYPE OF COMPLETION: (Circle One or More): Gravel Packed, Underreamed, Telescoped, Natural Development, Open Hole, Other (Describe) _____

WELL GROUTED TO A DEPTH OF 10 FEET
Type Grout (circle one): Cement, Bentonite, or Mix

LOG DATA

TYPE OF LOG RUN (Circle One): Electric, Gamma Ray, Density, Sonic, Neutron, Other (Describe) _____ No Log Run

Name of Organization Running Log

GEOLOGIC DATA (Office Use Only)

Surface Elev.	Geologic Unit	Unit Thickness	Depth to Top
Subs. SWL	Date	Analysis	Aquifer Test

Driller's Remarks

SCREEN DATA

Diameter - Inches	Length - Feet	Slot Size - Inches
2"	20'	.0006

Screen Type	Depth to Bottom - Feet
PVC	380'

Top of Lap Pipe or Reduction in Casing: FEET

IF TELESCOPED OR MORE THAN ONE SCREEN: USE BACK PAGE

DESCRIPTION OF FORMATIONS ENCOUNTERED	FROM	TO
Mud	0	120
Sand	120	130
Mud	130	340
Sand	340	380

FORMATIONS (Continued)	FROM	TO

IF MORE SPACE IS NEEDED, USE BACK

RECEIVED
NOV 0 7 1995
Dept. of Environmental Quality
Office of Land & Water Resources

If well telescopes please sketch and show depths.

GROUND LEVEL

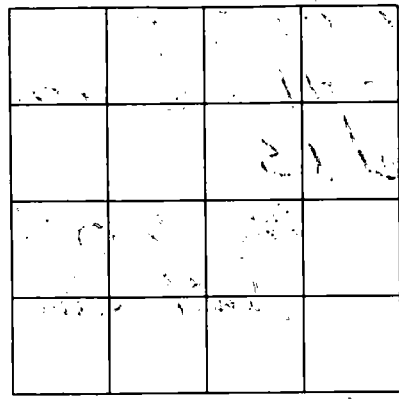

SECTION _____

Please indicate well location X.

ADDITIONAL INFORMATION

If more than one screen, show location of each on sketch.