HAR. C 58
4-28-65

MISSISSIPPI BOARD OF WATER COMMISSIONERS

WATER WELL DRILLERS LOG

Date: Apr 28, 1965, Driller: Joe Miller (Name) County Harrison

(1) Owner of Land: Flowers (Name)
RR# Saucier Miss (Address)

(2) Location: ____ ¼, ____ ¼, Sec. ____ T ____ R ____,
16' miles (distance) North (direction), of Gulfport (Nearest Town),

(3) Topography: Hilly (Hilly) (Flat) (Level)

(4) Purpose of Well: Domestic (Domestic Irrigation Municipal, Industrial, Other)

Information upon completion of well:

(1) Diameter 2" inches.

(2) Total Depth 331 feet.

(3) Water Level 43' feet below top of ground.

(4) Cased to 321, Size 2",

(5) Screen: Size 2", Length 10'.

(6) Were any formations sealed against pollution?

____ yes, ____ no.

If YES depth of formation ____,

Why ____

Drillers Remarks: ____

Description & Color of Materials Sand, Clay, Red Clay, Shell, etc.	Thickness Feet	Depth Feet
Surface	8	8
Red Sand Red Clay	22	30
Bright Tan Sand	15	45
Red Sand & Clay (Fine)	33	78
Brown & White Clay	5	83
White Clay	54	137
Tan Sand.	8	145
Cap Rock. (Iron)	2	147
Blue Clay	23	170
Break, NG	6	176
Hard Blue Clay	24	200
Tan Sand. (Fair)	26	226
Hard Blue Clay	37	263
Grey Sand. (Fine)	22	285
" " (Fair)	10	295
" " Good	11	306
" " "	11	317
" " Real Good		327
" " Still "		331
Still in Sand		
		101

(Use Back Side)

Well No.

RECEIVED OCT 1 1965 MISS. BOARD OF WATER COMM.

Mail this copy to Board of Water Commissioners 429 Miss. St. Jackson. Miss

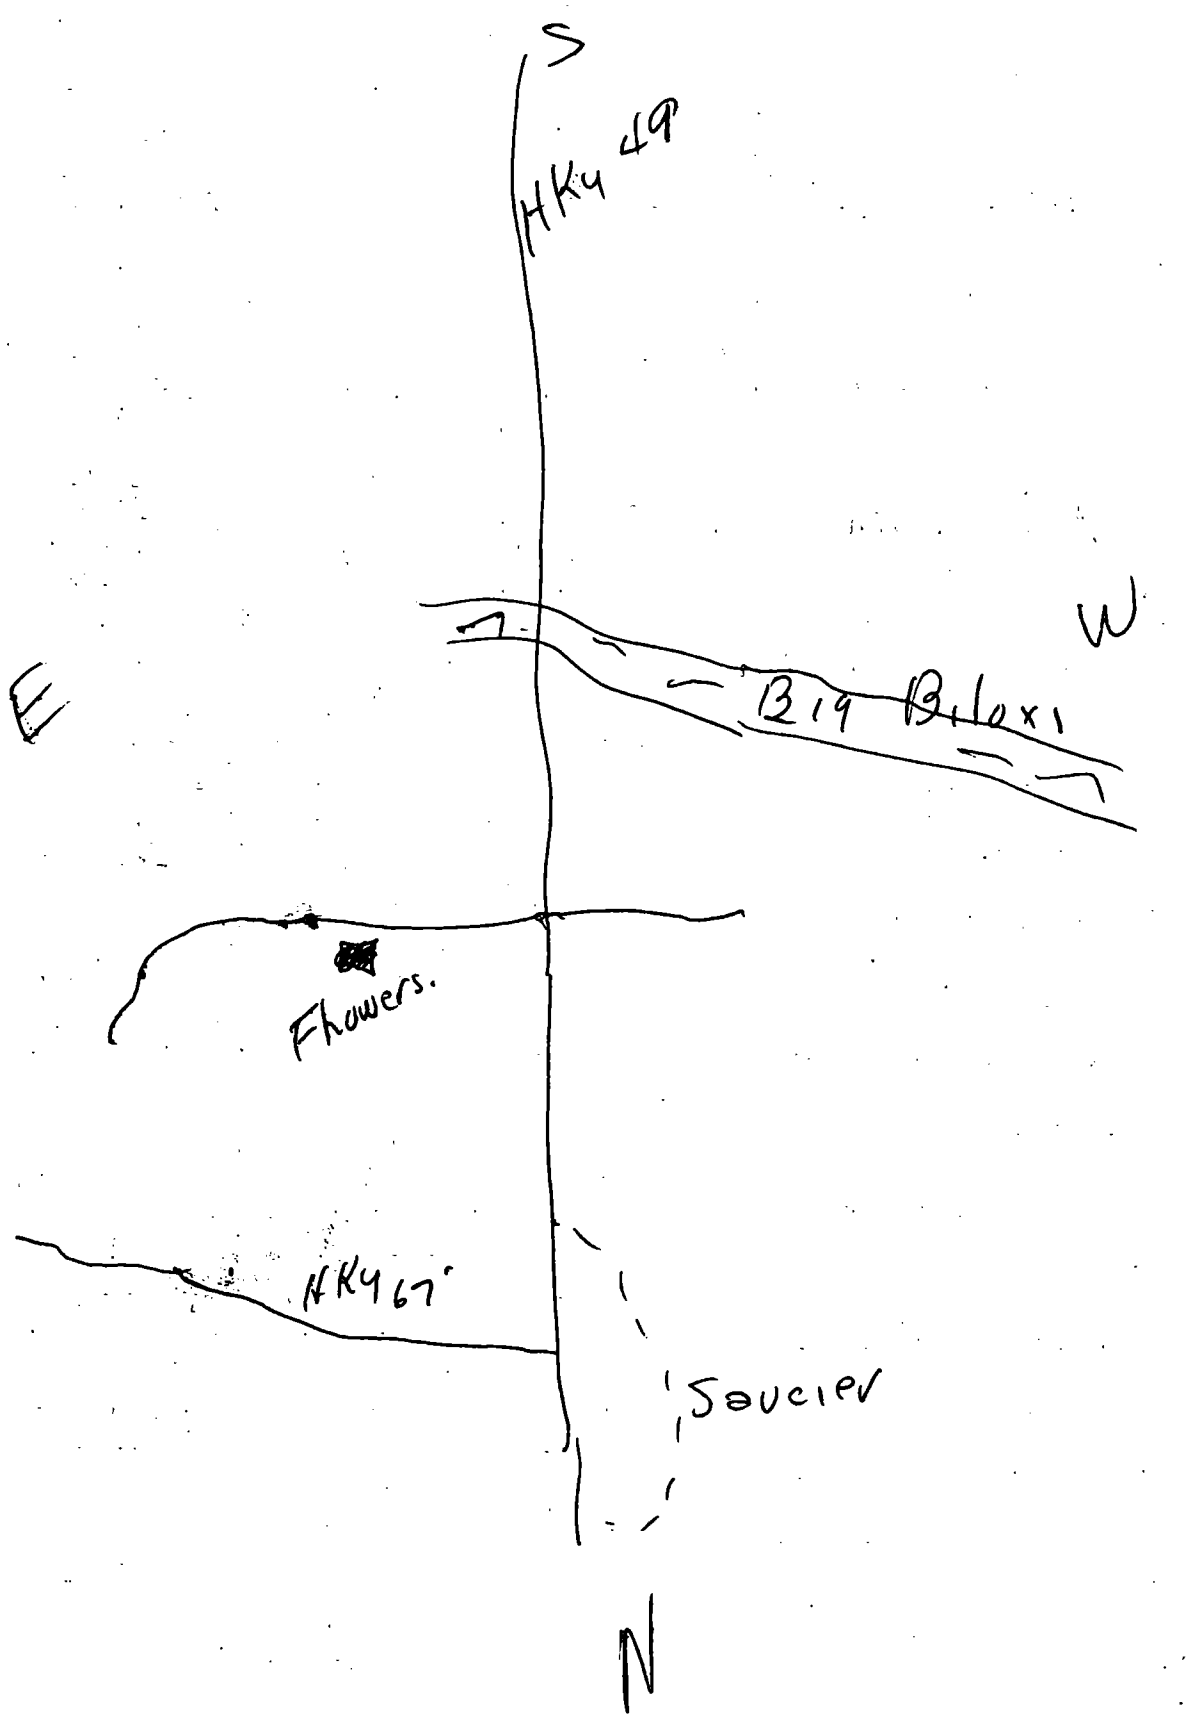
S
HKY 49
W
E
Big Biloxi
Flowers.
HKY 67
Saucier
N