

**MISSISSIPPI
BOARD OF WATER COMMISSIONERS CODED**
416 North State Street
Jackson, Mississippi 39201

~~CODED~~

WATER WELL DRILLERS LOG

COASTAL DRILLING & SERVICE CO.

ROUTE # 11 BOX 618

county well located

date well completed

LANDOWNER

description of formations encountered

from to

W.B. Owen
PO # 128
Sauvignin
(mailing address)

<u>stop soil</u>	<u>1</u>	<u>3</u>
<u>hard Red Clay</u>	<u>3</u>	<u>18</u>
<u>white sand</u>	<u>18</u>	<u>35</u>
<u>Soft blue clay</u>	<u>35</u>	<u>230</u>
<u>white sand</u>	<u>230</u>	<u>250</u>
<u>hard blue clay</u>	<u>250</u>	<u>525</u>
<u>rocky clay</u>	<u>525</u>	<u>530</u>
<u>fine white sand</u>	<u>530</u>	<u>550</u>
<u>hard blue clay</u>	<u>550</u>	<u>570</u>
<u>fine white sand</u>	<u>570</u>	<u>590</u>
<u>coarse white sand</u>	<u>590</u>	<u>635</u>

WELL LOCATION:

sec. 31 T. 4 N. R. 11 E. 13-5
S. W.
None miles NE of Spaulding
(distance) (direction) (nearest town)

WELL PURPOSE:

(home, irrigation, municipal/industrial)

WELL COMPLETION DATA:

- diameter (inches) 2"
- total depth (feet) 635
- static water level (feet) 40 below above top of ground.
- casing PVC 620'
(material) (depth)
- screen 15' 620'
(length) (depth to top)
2" PVC
(size) (material)
- pump One 12
(HP) (yield gpm)
Ele
(type power)
- electric log No
(yes or no)


CODED

(organization running log)

(8) how well bottom plugged

24" hard wood block


DRILLERS REMARKS:

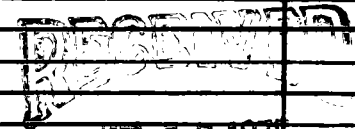

17 1975

If well telescopes please sketch and show depths.

GROUND LEVEL

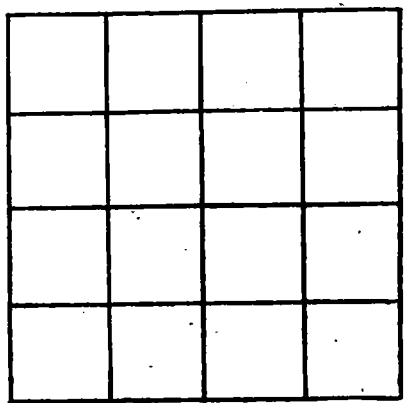

SECTION _____

Please indicate well location X.

ADDITIONAL INFORMATION

A series of horizontal lines for providing additional information.

If more than one screen, show locations of each on sketch.