Harrison
C. 278
12/31/84

MISSISSIPPI DEPARTMENT OF NATURAL RESOURCES
Bureau of Land and Water Resources
Southport Mall
P.O. Box 10631
Jackson, Mississippi 39209

CODED

WATER WELL DRILLERS LOG

12/31 1984 — date well completed
Braden's Pump + Well Serv — firm name
Harrison — county well located

LANDOWNER:
Vernon Lee Williams
Rt. 2, Box 24F Saucier 39574
(mailing address)

WELL LOCATION:
sec. 20 T 5 S R 11 W
2½ miles S of Saucier
(distance) (direction) (nearest town)

WELL PURPOSE: Home
(home, irrigation, municipal, industrial)

WELL COMPLETION DATA:

(1) diameter (inches) 4" x 2"
(2) total depth (feet) 400
(3) static water level (feet) 60 below ~~above~~ top of ground.
(4) casing PVC (material), total (depth),
4" x 2" (size) if telescope see back.
(5) screen 10' (length), 370' (depth to top)
2" (size), PVC (material)
(6) pump 1 Sub. (HP) 25 (yield gpm)
230 Volts (type power)
(7) electric log no (yes or no)
(organization running log)
(8) how well bottom plugged: Back Wash Check

DRILLERS REMARKS:
20' tailpipe

description of formations encountered	from	to
Clay	0	60
Sand + Clay	60	100
Clay + Sand	100	160
Clay	160	220
Sand + Clay	220	260
Sand	260	380
Clay	380	400

1-22-85
LHW

If well telescopes please sketch and show depths.

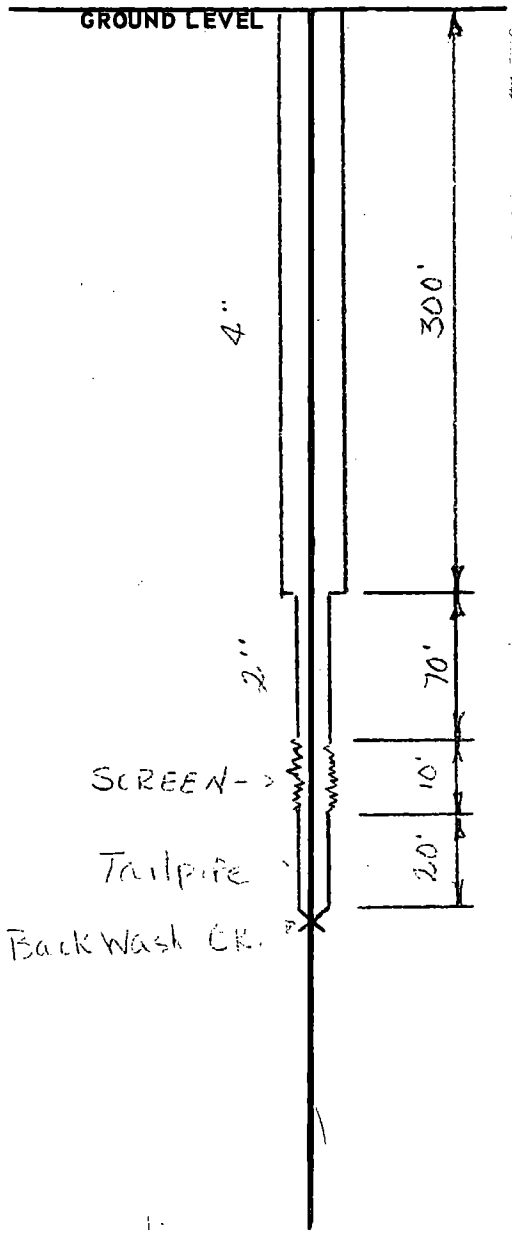

If more than one screen, show locations of each on sketch.

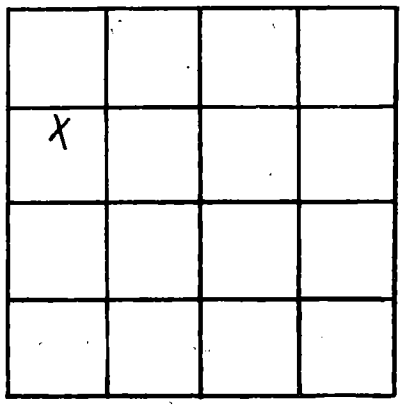

SECTION 20

Please indicate well location X.

ADDITIONAL INFORMATION