MISSISSIPPI DEPARTMENT OF ENVIRONMENTAL QUALITY
Bureau of Land and Water Resources

P. O. Box 10631
Jackson, MS 39289-0631
WATER WELL DRILLERS LOG

COUNTY WELL LOCATED: Harrison	
WELL NUMBER: C 290	CODED: ✓
DATE WELL COMPLETED: 7-12-90	
PERMIT NUMBER:	
NAME OF DRILLING COMPANY: Coastal Drilling & Service Co. 8456 Woolmarket Biloxi Road Biloxi, Mississippi 39532	

NAME & MAILING ADDRESS OF LANDOWNER: Steve Johnston
2205 3 D.B Johnston Dr.
Saucier, Ms

WELL LOCATION: SEC 13 TOWNSHIP 5 N/S RANGE 11 E/W
Harrison

DISTANCE ____ Miles DIRECTION ____ NEAREST TOWN Saucier City

OTHER LANDMARK Hwy 67

WELL PURPOSE: (Home), Irrigation, Municipal, Industrial, Fish Pond, etc.

PUMP DATA

PUMP TYPE (Circle One): Submersible, Turbine, (Jet) Flowing Well, Other (Describe) ____

POWER TYPE (Circle One): (Electric) Tractor, Diesel, Gasoline, Butane, Other (Describe) ____ H/P ____

Pump Capacity (GPM)	No. of Stages	Setting Depth
10	2	80 FT.

PUMP TEST

Well yielded 10 GPM with a drawdown of 0 ft. after 4 hours of pumping

WELL DATA

Well Depth	Casing Diameter (In.)	Casing Length (Ft.)
740'	2"	720'

Type of Casing	Hole Depth	Depth to Static Water Level
PVC	740	60'

TYPE OF COMPLETION: (Circle One or More): Gravel Packed, Underreamed, Telescoped, (Natural Development), Open Hole, Other (Describe) ____

Top of Lap Pipe or Reduction in Casing FEET

IF TELESCOPED OR MORE THAN ONE SCREEN: USE BACK PAGE

LOG DATA

TYPE OF LOG RUN (Circle One): No Log Run, Electric, Gamma Ray, Density, Sonic, Neutron, Other (Describe) ____

Name of Organization Running Log

GEOLOGIC DATA (Office Use Only)

Surface Elev.	Geologic Unit	Unit Thickness	Depth to Top
Subs. SWL	Date	Analysis	Aquifer Test

Driller's Remarks

None

SCREEN DATA

Diameter - Inches	Length - Feet	Slot Size - Inches
2"	20'	.008

Screen Type	Depth to Bottom - Feet
PVC	740'

DESCRIPTION OF FORMATIONS ENCOUNTERED	FROM	TO	FORMATIONS (Continued)	FROM	TO
top soil	1'	3'			
Red sand	3'	12'			
White sand	12'	22'			
soft Blue clay	22	85'			
Hard Blue clay	85'	410'			
fine water sand	410	440'			
Hard Blue clay	440'	710	1-25-93		
fine water sand	710'	720'			
Coarse water sand	720	740'			
			IF MORE SPACE IS NEEDED, USE BACK		

If well telescopes please sketch and show depths.

GROUND LEVEL

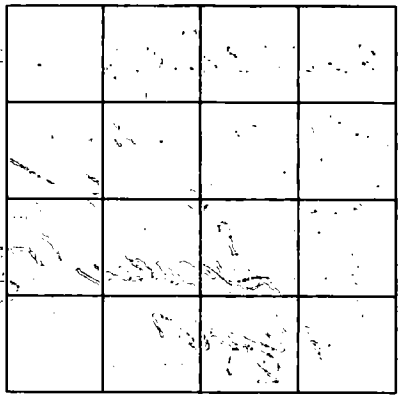

SECTION _____

Please indicate well location X.

ADDITIONAL INFORMATION

If more than one screen, show location of each on sketch.