Harrison
C
2030

MISSISSIPPI DEPARTMENT OF NATURAL RESOURCES
Bureau of Land and Water Resources
Southport Mall
P.O. Box 10631
Jackson, Mississippi 39209

WATER WELL DRILLERS LOG

12-17 1994 — date well completed
Frank Pics — firm name
Harrison — county well located

LANDOWNER: George Baker
(mailing address)

WELL LOCATION: ~~Hancock~~
sec. 13 T 5 S R 11 W
Success miles (distance) (direction) of (nearest town)

WELL PURPOSE: HOME
(home, irrigation, municipal, industrial)

WELL COMPLETION DATA:

(1) diameter (inches) 2"
(2) total depth (feet) 83'
(3) static water level (feet) 55 below ~~above~~ top of ground.
(4) casing PVC (material), 78' (depth),
(size) If telescope see back.
(5) screen 5' (length), 78' (depth to top)
2" (size), PVC (material)
(6) pump 1 (HP) 8 (yield gpm)
Elect (type power)
(7) electric log no (yes or no)
(organization running log)
(8) how well bottom plugged
B.W.V.

DRILLERS REMARKS:

description of formations encountered	from	to
Top Soil	0	2
Sandy Clay	2	18
Clay	18	40
Fine Sand	40	70
Coarse Sand	70	83

S.W.L. 1-7-95

If well telescopes please sketch and show depths.

GROUND LEVEL

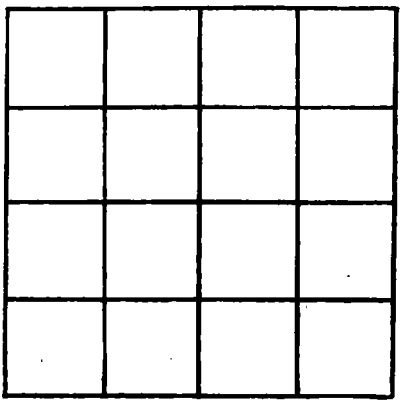

SECTION _____

Please indicate well location X.

ADDITIONAL INFORMATION

If more than one screen, show locations of each on sketch.