HARRISON
C 2032
8-21-80

MISSISSIPPI
BOARD OF WATER COMMISSIONERS
416 North State Street
Jackson, Mississippi 39201

WATER WELL DRILLERS LOG

8-21- 19 80 Farnell Anderson Harrison
date well completed — firm name — county well located

LANDOWNER: Steven Treigle

Gulfport, Ms
(mailing address)

WELL LOCATION:
sec. 14 T 5 N/S R 11 E/W
1 1/2 miles SE of Saucier
(distance) (direction) (nearest town)

WELL PURPOSE: home
(home, irrigation, municipal, industrial)

WELL COMPLETION DATA:

(1) diameter (inches) 2"
(2) total depth (feet) 105'
(3) static water level (feet) 30 below/above top of ground.
(4) casing Plastic (material), 40' (depth),
_____ (size) if telescope see back.
(5) screen 5' (length), 40' (depth to top)
_____ (size), _____ (material)
(6) pump 1 (HP) D (yield gpm)
Electric (type power)
(7) electric log No (yes or no)
_____ (organization running log)
(8) how well bottom plugged Copper

DRILLERS REMARKS:

description of formations encountered	from	to
Top soil	0	3
Clay	3	46
Fine Sand	46	82
Corse Sand	82	105

DEPT. OF NATURAL RESOURCES
BUREAU OF LAND & WATER RESOURCES
OCT 14 1980
RECEIVED

If well telescopes please sketch and show depths.

GROUND LEVEL

If more than one screen, show locations of each on sketch.

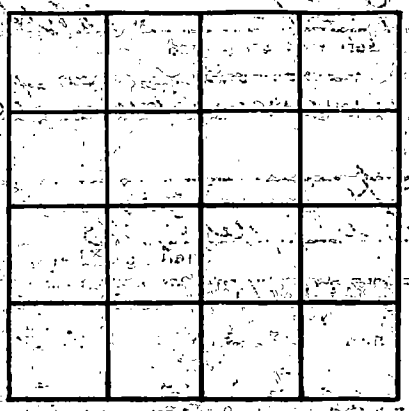

SECTION

Please indicate well location X.

ADDITIONAL INFORMATION