# MISSISSIPPI DEPARTMENT OF NATURAL RESOURCES

Bureau of Land and Water Resources

P.O. Box 10631
Jackson, Mississippi 39209
WATER WELL DRILLERS LOG

| | |
|---|---|
| COUNTY WELL LOCATED: HARRISON | |
| WELL NUMBER: C 2070 | CODED: |
| DATE WELL COMPLETED: 5-12-88 | |
| PERMIT NUMBER: N/A. | |
| NAME OF DRILLING FIRM: PATSE DRILLING, Lic. 0-487 | |

NAME & MAILING ADDRESS OF LANDOWNER
Clyde Schiber
18312 Hy. 49 Gulfport
Miss. Zip 39574.

| WELL LOCATION: | SEC | TOWNSHIP | RANGE |
|---|---|---|---|
| Saucier | 19 | 5 | N S 11 E (W) |

| DISTANCE | DIRECTION | NEAREST TOWN |
|---|---|---|
| 5 Miles | W/ | of OBANYE-D-Inc |

OTHER LANDMARK

WELL PURPOSE: Home, Irrigation, Municipal, Industrial, Fish Pond, etc.
Home.

## PUMP DATA

PUMP TYPE (Circle One): Submersible, Turbine, (Jet) Flowing Well, Other (Describe)

POWER TYPE (Circle One): (Electric) Tractor, Diesel, Gasoline, Butane, Other (Describe)

| Pump Capacity (GPM) | No. of Stages | Setting Depth |
|---|---|---|
| 12" GPM. | 2" | 65" FT. |

PUMP TEST

Well yielded 40" GPM with a drawdown of 3" ft. after 36" hours of pumping

## WELL DATA

| Well Depth | Casing Diameter (In.) | Casing Length (Ft.) |
|---|---|---|
| 180" | 2" | 20" ft |

| Type of Casing | Hole Depth | Depth to Static Water Level |
|---|---|---|
| PVC. | 180 | 170 |

TYPE OF COMPLETION: (Circle One or More): Gravel Packed, Underreamed, Telescoped, (Natural Development), Open Hole, Other (Describe)

Top of Lap Pipe or Reduction in Casing FEET

IF TELESCOPED OR MORE THAN ONE SCREEN: USE BACK PAGE

## SCREEN DATA

| Diameter - Inches | Length - Feet | Slot Size - Inches |
|---|---|---|
| 2" | 10" | 8" |

| Screen Type | Depth to Bottom - Feet |
|---|---|
| P.V.C. Sch. 40 | 180" |

## LOG DATA

TYPE OF LOG RUN (Circle One): (No Log Run), Electric, Gamma Ray, Density, Sonic, Neutron, Other (Describe)

Name of Organization Running Log
N/A

## GEOLOGIC DATA (Office Use Only)

| Surface Elev. | Geologic Unit | Unit Thickness | Depth to Top |
|---|---|---|---|
| Subs. SWL | Date | Analysis | Aquifer Test |

Driller's Remarks

RECEIVED
MAY 27 1988
Department of Natural Resources
Bureau of Land & Water Resources

| DESCRIPTION OF FORMATIONS ENCOUNTERED | FROM | TO |
|---|---|---|
| SAND CLAY. | 0 | 20 |
| WIGHT CLAY. | 20 | 80 |
| BLUE CLAY. | 80 | 140 |
| CRYSTAL CLAY. | 140 | 180 |

| FORMATIONS (Continued) | FROM | TO |
|---|---|---|
| | | |

IF MORE SPACE IS NEEDED, USE BACK

If well telescopes please
sketch and show depths.

GROUND LEVEL

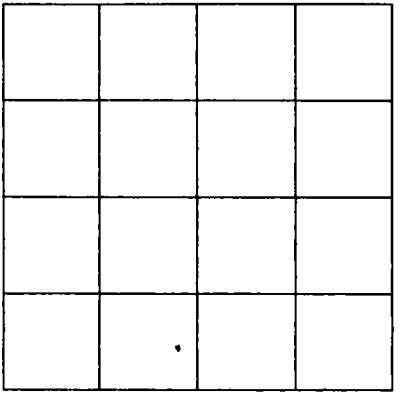

SECTION _____

Please indicate well location X.

ADDITIONAL INFORMATION

If more than one screen,
show location of each on sketch.