MISSISSIPPI DEPARTMENT OF NATURAL RESOURCES

Bureau of Land and Water Resources

P.O. Box 10631
Jackson, Mississippi 39209

WATER WELL DRILLERS LOG

COUNTY WELL LOCATED: HARRISON	
WELL NUMBER: C 2080	CODED
DATE WELL COMPLETED: 8-9-90	
PERMIT NUMBER: 404	
NAME OF DRILLING FIRM: Lyman Well Co. Gulfport MS	

NAME & MAILING ADDRESS OF LANDOWNER:
Leonard Juran
22534 Juran Rd.
Saucier MS 39574

WELL LOCATION: SEC 10 TOWNSHIP 5 N/S RANGE 11 E/W

(10 11W 5S)

DISTANCE ____ Miles DIRECTION ____ of NEAREST TOWN ____

OTHER LANDMARK

WELL PURPOSE: Home, Irrigation, Municipal, Industrial, Fish Pond, etc.

PUMP DATA

PUMP TYPE (Circle One): Submersible, Turbine, Jet, Flowing Well, Other (Describe) Jet Pump

POWER TYPE (Circle One): Electric, Tractor, Diesel, Gasoline, Butane, Other (Describe) ____ H/P 1

Pump Capacity (GPM)	No. of Stages	Setting Depth
12	2	60' FT.

PUMP TEST

Well yielded ____ GPM with a drawdown of ____ ft. after ____ hours of pumping

WELL DATA

Well Depth	Casing Diameter (In.)	Casing Length (Ft.)
110'	2"	100'

Type of Casing	Hole Depth	Depth to Static Water Level
PVC		37'

TYPE OF COMPLETION: (Circle One or More): Gravel Packed, Underreamed, Telescoped, Natural Development, Open Hole, Other (Describe) ____

Top of Lap Pipe or Reduction in Casing: NA FEET

IF TELESCOPED OR MORE THAN ONE SCREEN: USE BACK PAGE

SCREEN DATA

Diameter - Inches	Length - Feet	Slot Size - Inches
2"	10	

Screen Type	Depth to Bottom - Feet
PVC	

LOG DATA

TYPE OF LOG RUN (Circle One): No Log Run, Electric, Gamma Ray, Density, Sonic, Neutron, Other (Describe) ____

Name of Organization Running Log

GEOLOGIC DATA (Office Use Only)

Surface Elev.	Geologic Unit	Unit Thickness	Depth to Top
Subs. SWL	Date	Analysis	Aquifer Test

Driller's Remarks

DESCRIPTION OF FORMATIONS ENCOUNTERED	FROM	TO
top soil	0	3
yellow Clay	3	23
Blue Clay	23	80
Sand	80	100

FORMATIONS (Continued)	FROM	TO

IF MORE SPACE IS NEEDED, USE BACK

RECEIVED
OCT 23 1990
Department of Natural Resources
Bureau of Land & Water Resources

If well telescopes please
sketch and show depths.

GROUND LEVEL

 

If more than one screen,
show location of each on sketch.

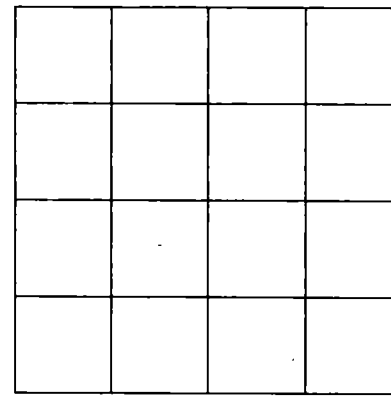

SECTION _____

Please indicate well location X.

ADDITIONAL INFORMATION