MISSISSIPPI DEPARTMENT OF NATURAL RESOURCES

Bureau of Land and Water Resources

P.O. Box 10631
Jackson, Mississippi 39209
WATER WELL DRILLERS LOG

COUNTY WELL LOCATED: Harrison
WELL NUMBER: C 2090 | CODED:
DATE WELL COMPLETED: 9-2-88

PERMIT NUMBER:
NAME OF DRILLING COMPANY: Coastal Drilling & Service Co.
8456 Woolmarket Biloxi Road
Biloxi, Mississippi 39532

NAME & MAILING ADDRESS OF LANDOWNER
Carlos Castol
Highway 49
Gulfport, Ms.

WELL LOCATION: COUNTY | SEC | TOWNSHIP | RANGE
Harrison | 19 | 5 (N) (S) | 11 (E) (W)

DISTANCE | DIRECTION | NEAREST TOWN
2 Miles | S of | SAUCIER

OTHER LANDMARK: Honeybranch

WELL PURPOSE: (Home), Irrigation, Municipal, Industrial, Fish Pond, etc.
Home

PUMP DATA

PUMP TYPE (Circle One): Submersible, Turbine, (Jet), Flowing Well, Other (Describe) _____

POWER TYPE (Circle One): (Electric), Tractor, Diesel, Gasoline, Butane, Other (Describe) _____

Pump Capacity (GPM)	No. of Stages	Setting Depth
10	2	80 FT.

PUMP TEST
Well yielded 10 GPM with a drawdown of 0 ft. after 5 hours of pumping

WELL DATA

Well Depth	Casing Diameter (In.)	Casing Length (Ft.)
260'	6"	240'

Type of Casing	Hole Depth	Depth to Static Water Level
PVC	260'	60

TYPE OF COMPLETION: (Circle One or More): Gravel Packed, Underreamed, Telescoped, (Natural Development), Open Hole, Other (Describe) _____

Top of Lap Pipe or Reduction in Casing
FEET | IF TELESCOPED OR MORE THAN ONE SCREEN: USE BACK PAGE

SCREEN DATA

Diameter - Inches	Length - Feet	Slot Size - Inches
6"	20'	.008

Screen Type	Depth to Bottom - Feet
PVC	260

LOG DATA

TYPE OF LOG RUN (Circle One): No Log Run, Electric, Gamma Ray, Density, Sonic, Neutron, Other (Describe) _____

Name of Organization Running Log

GEOLOGIC DATA (Office Use Only)

Surface Elev.	Geologic Unit	Unit Thickness	Depth to Top
Subs. SWL	Date	Analysis	Aquifer Test

Driller's Remarks
None

DESCRIPTION OF FORMATIONS ENCOUNTERED	FROM	TO
top soil	1'	3'
red sand	3'	9'
White sand	9'	22'
Soft Blue Clay	22'	65'
Hard Blue clay	65'	160'
fine water sand	160'	180'
Hard Blue Clay	180'	220'
fine water sand	220	240'
Coarse water sand	240'	260'

FORMATIONS (Continued)	FROM	TO

RECEIVED
FEB 05 1992
Dept. of Environmental Quality
Bureau of Land & Water Resources

IF MORE SPACE IS NEEDED, USE BACK

If well telescopes please sketch and show depths.

GROUND LEVEL

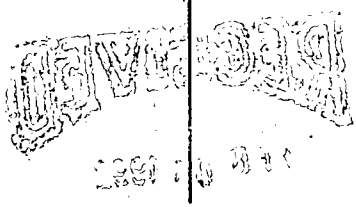

If more than one screen, show location of each on sketch.

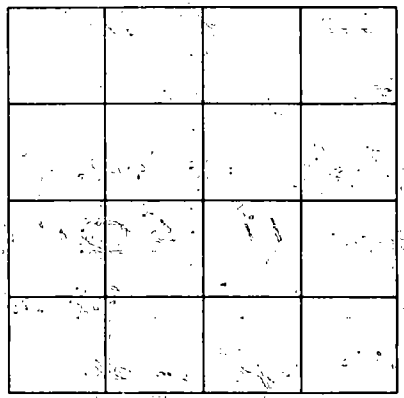

SECTION _____

Please indicate well location X.

ADDITIONAL INFORMATION