Harrison
E
2045

MISSISSIPPI DEPARTMENT OF NATURAL RESOURCES
Bureau of Land and Water Resources
Southport Mall
P.O. Box 10631
Jackson, Mississippi 39209
WATER WELL DRILLERS LOG

8-5 1983 McGill Wells, Inc. Harrison
date well completed — firm name — county well located

LANDOWNER: John Moran
RT 3 Box 161
Pass Christian, Ms 39571
(mailing address)

WELL LOCATION:
sec. 31 T 6 N (S) R 13 (E) W
6 miles N of P.C
(distance) (direction) (nearest town)

WELL PURPOSE: Home
(home, irrigation, municipal, industrial)

WELL COMPLETION DATA:

(1) diameter (inches) 2"
(2) total depth (feet) 315'
(3) static water level (feet) — below above top of ground.
(4) casing 40 PVC (material), 305' (depth),
— (size) if telescope see back.
(5) screen 10' (length), 305' (depth to top)
2" (size), 80 PVC 6-slot (material)
(6) pump 1 (HP) (yield gpm)
electric (type power)
(7) electric log no (yes or no)
— (organization running log)
(8) how well bottom plugged Sand Seal

DRILLERS REMARKS:

description of formations encountered	from	to
Mud	0	60
Sand	60	80
Mud	80	180
Sand	180	200
Mud	200	205
Sand	205	315

DEPT. OF NATURAL RESOURCES
BUREAU OF LAND & WATER RESOURCES
JAN 17 1984
RECEIVED

If well telescopes please sketch and show depths.

GROUND LEVEL

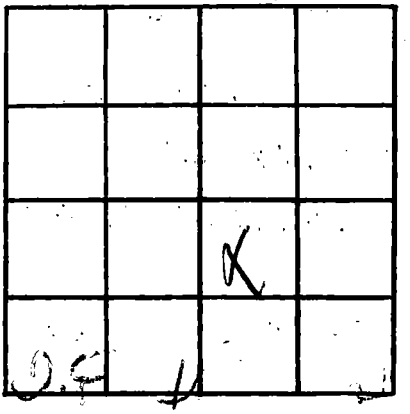

SECTION 31

Please indicate well location X.

ADDITIONAL INFORMATION

If more than one screen, show locations of each on sketch.