MISSISSIPPI DEPARTMENT OF NATURAL RESOURCES

Bureau of Land and Water Resources

P.O. Box 10631
Jackson, Mississippi 39209

WATER WELL DRILLERS LOG

COUNTY WELL LOCATED: Harrison	PERMIT NUMBER: 0239
WELL NUMBER: E 2053 / CODED:	NAME OF DRILLING FIRM: MCGILL PUMP & WELLS, RT1 BOX 1643 CANAL RD, GULPT, MS 39503
DATE WELL COMPLETED: Dec 1-86	

NAME & MAILING ADDRESS OF LANDOWNER: Crystal Bobbitt, Saucier/Lizana Rd, Lizana

WELL LOCATION: SEC 6 TOWNSHIP 6 N (S) RANGE 13 E (W)

DISTANCE 2 Miles DIRECTION North of NEAREST TOWN Lizana

OTHER LANDMARK:

WELL PURPOSE: (Home), Irrigation, Municipal, Industrial, Fish Pond, etc.

PUMP DATA

PUMP TYPE (Circle One): Submersible, Turbine, (Jet), Flowing Well, Other (Describe) 1 hp Star-rite

POWER TYPE (Circle One): (Electric), Tractor, Diesel, Gasoline, Butane, Other (Describe)

Pump Capacity (GPM)	No. of Stages	Setting Depth
8	2	120' FT.

PUMP TEST

Well yielded 8 GPM with a drawdown of 3 ft. after 1 hours of pumping

WELL DATA

Well Depth	Casing Diameter (In.)	Casing Length (Ft.)
415'	2"	415'
Type of Casing	**Hole Depth**	**Depth to Static Water Level**
PVC	415'	103'

TYPE OF COMPLETION: (Circle One or More): Gravel Packed, Underreamed, Telescoped, (Natural Development), Open Hole, Other (Describe)

Top of Lap Pipe or Reduction in Casing FEET

IF TELESCOPED OR MORE THAN ONE SCREEN: USE BACK PAGE

LOG DATA

TYPE OF LOG RUN (Circle One): (No Log Run), Electric, Gamma Ray, Density, Sonic, Neutron, Other (Describe)

Name of Organization Running Log

GEOLOGIC DATA (Office Use Only)

Surface Elev.	Geologic Unit	Unit Thickness	Depth to Top
Subs. SWL	Date	Analysis	Aquifer Test

Driller's Remarks

SCREEN DATA

Diameter - Inches	Length - Feet	Slot Size - Inches
2"	10'	6 ths
Screen Type		**Depth to Bottom - Feet**
PVC		415'

RECEIVED
JAN 14 1987
Department of Natural Resources
Bureau of Land & Water Resources

DESCRIPTION OF FORMATIONS ENCOUNTERED	FROM	TO	FORMATION DESCRIPTION	FROM	TO
mud	0	50			
Sand	60	130			
mud	130	280			
Sand	280	300			
mud	300	380			
Sand	380	415			
			IF MORE SPACE IS NEEDED, USE BACK		

If well telescopes please
sketch and show depths.

GROUND LEVEL

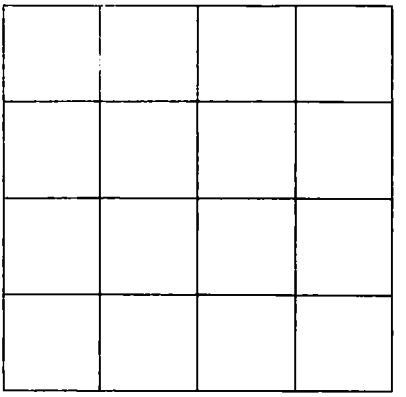

SECTION _____

Please indicate well location X.

ADDITIONAL INFORMATION

If more than one screen,
show location of each on sketch.