MISSISSIPPI DEPARTMENT OF ENVIRONMENTAL QUALITY
Office of Land and Water Resources

P. O. Box 10631
Jackson, MS 39289-0631

WATER WELL DRILLERS LOG

COUNTY WELL LOCATED	HARRISON
WELL NUMBER	E-2109
CODED	
PERMIT NUMBER	
NAME OF DRILLING FIRM	NECHASE WELL SERVICE
DATE WELL COMPLETED	06-01-01

NAME & MAILING ADDRESS OF LANDOWNER
BRAD CUEVAS
CABLE BRIDGE RD
GULFPORT MS 39503

WELL LOCATION	SEC	TOWNSHIP	RANGE
	35	6 N	13 E

DISTANCE	DIRECTION	NEAREST TOWN
4 Miles	S of	LIZANA

OTHER LANDMARK

WELL PURPOSE: Home, Irrigation, Municipal, Industrial, Fish Pond, etc.

PUMP DATA

PUMP TYPE (Circle One): Submersible, Turbine, Jet, Flowing Well, Other (Describe) _____

POWER TYPE (Circle One): Electric, Tractor, Diesel, Gasoline, Butane, Other (Describe) _____ H/P 1

Pump Capacity (GPM)	No. of Stages	Setting Depth
20		100 FT.

PUMP TEST

Well yielded _____ GPM with a drawdown of _____ ft. after _____ hours of pumping

WELL DATA

Well Depth	Casing Diameter (In.)	Casing Length (Ft.)
450	2x4	430

Type of Casing	Hole Depth	Depth to Static Water Level
PVC	450	60

TYPE OF COMPLETION: (Circle One or More): Gravel Packed, Underreamed, Telescoped, Natural Development, Open Hole, Other (Describe) _____

WELL GROUTED TO A DEPTH OF 12 FEET
Type Grout (circle one): Cement, Bentonite, or Mix

LOG DATA

TYPE OF LOG RUN (Circle One): Electric, Gamma Ray, Density, Sonic, Neutron, No Log Run, Other (Describe) _____

Name of Organization Running Log

GEOLOGIC DATA (Office Use Only)

Surface Elev.	Geologic Unit	Unit Thickness	Depth to Top
Subs. SWL	Date	Analysis	Aquifer Test

SCREEN DATA

Diameter - Inches	Length - Feet	Slot Size - Inches
2	20	.006

Screen Type	Depth to Bottom - Feet
PVC	450

Driller's Remarks
140' 4" CASING
290' 2" CASING

Top of Lap Pipe or Reduction in Casing
FEET — IF TELESCOPED OR MORE THAN ONE SCREEN: USE BACK PAGE

DESCRIPTION OF FORMATIONS ENCOUNTERED	FROM	TO	FORMATIONS (Continued)	FROM	TO
SAND	0	40			
W. CLAY	40	50			
B. CLAY	50	120			
SAND	120	140			
CLAY	140	180			
SAND	180	220			
			IF MORE SPACE IS NEEDED, USE BACK		

REC'D JUL 02 2001

If well telescopes please sketch and show depths.

GROUND LEVEL

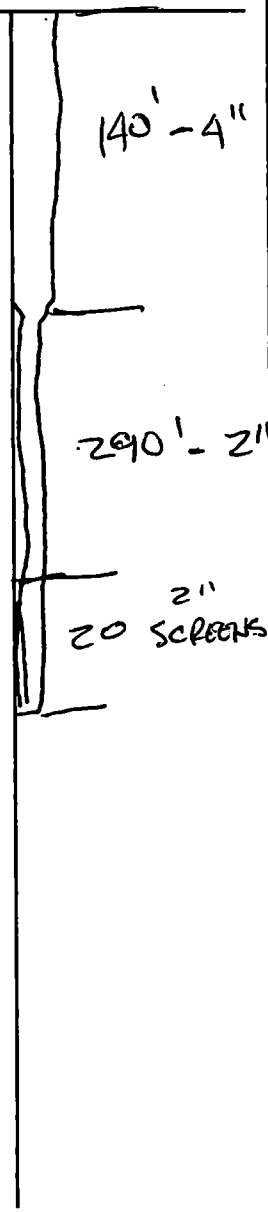

If more than one screen, show location of each on sketch.

SECTION _____

Please indicate well location X.

ADDITIONAL INFORMATION