MISSISSIPPI DEPARTMENT OF ENVIRONMENTAL QUALITY
Office of Land and Water Resources

P. O. Box 10631
Jackson, MS 39289-0631

WATER WELL DRILLERS LOG

COUNTY WELL LOCATED	Harrison
WELL NUMBER	26
CODED	
	E-2110
DATE WELL COMPLETED	12/19/99
PERMIT NUMBER	O-493
NAME OF DRILLING FIRM	BEECH WELL WORKS

NAME & MAILING ADDRESS OF LANDOWNER: Bonnie Lizana
Mattox Homes
Northrop Cuevas Rd
Gpt 39503

WELL LOCATION — SEC: 30 TOWNSHIP: 6 N (S) RANGE: 13 E (W)

DISTANCE _____ Miles DIRECTION _____ of NEAREST TOWN _____

OTHER LANDMARK

WELL PURPOSE: Home, Irrigation, Municipal, Industrial, Fish Pond, etc.

PUMP DATA

PUMP TYPE (Circle One): Submersible, Turbine, Jet, Flowing Well, Other (Describe) _____

POWER TYPE (Circle One): Electric, Tractor, Diesel, Gasoline, Butane, Other (Describe) _____ H/P _____

Pump Capacity (GPM)	No. of Stages	Setting Depth
12	2	80 FT.

PUMP TEST

Well yielded _____ GPM with a drawdown of _____ ft. after _____ hours of pumping

WELL DATA

Well Depth	Casing Diameter (In.)	Casing Length (Ft.)
320	2	300

Type of Casing	Hole Depth	Depth to Static Water Level
PVC	320	60 ft

TYPE OF COMPLETION: (Circle One or More): Gravel Packed, Underreamed, Telescoped, Natural Development, Open Hole, Other (Describe) _____

WELL GROUTED TO A DEPTH OF 10 FEET
Type Grout (circle one): Cement, Bentonite, or Mix

SCREEN DATA

Diameter - Inches	Length - Feet	Slot Size - Inches
2	20	.006

Screen Type	Depth to Bottom - Feet
PVC	

LOG DATA

TYPE OF LOG RUN (Circle One): Electric, Gamma Ray, Density, Sonic, Neutron, No Log Run, Other (Describe) _____

Name of Organization Running Log

GEOLOGIC DATA (Office Use Only)

Surface Elev.	Geologic Unit	Unit Thickness	Depth to Top
Subs. SWL	Date	Analysis	Aquifer Test

Driller's Remarks

Top of Lap Pipe or Reduction in Casing _____ FEET

IF TELESCOPED OR MORE THAN ONE SCREEN: USE BACK PAGE

DESCRIPTION OF FORMATIONS ENCOUNTERED	FROM	TO	FORMATIONS (Continued)	FROM	TO
Red clay	0	17			
Red Sand	17	38			
White clay	38	90			
Blue clay	90	160			
Blue Fine Sand	160	190			
Hard Blue clay	190	270			
green Sand	270	320			
			IF MORE SPACE IS NEEDED, USE BACK		

RECD MAY 08 2001

If well telescopes please sketch and show depths.

GROUND LEVEL

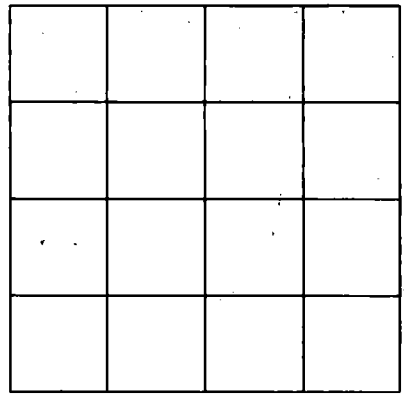

SECTION _____

Please indicate well location X.

ADDITIONAL INFORMATION

If more than one screen, show location of each on sketch.