Harrison
F72
3-27-70

MISSISSIPPI
BOARD OF WATER COMMISSIONERS
416 North State Street
Jackson, Mississippi 39201

CODED

WATER WELL DRILLERS LOG

3-27 19 70 R. J. MOORE HARRISON
date well completed — firm name — county well located

LANDOWNER: J.J. CUEVAS
Rt 1 Box 112
SAUCIER MISS.
(mailing address)

WELL LOCATION:
sec. 5 T 6 N R 12 E

2 miles North of LIZAMA
(distance) (direction) (nearest town)

WELL PURPOSE:
(home, irrigation, municipal, industrial)

WELL COMPLETION DATA:

(1) diameter (inches) 2'
(2) total depth (feet) 495'
(3) static water level (feet) 63' below above top of ground.
(4) casing PALV (material), 480' (depth),
2' (size) If telescope see back.
(5) screen 2X10 (length), 480' (depth to top)
2' (size), SS (material)
(6) pump 1 (HP) 620 HR (yield gpm)
Elec (type power)
(7) electric log _____ (yes or no)
_____ (organization running log)
(8) how well bottom plugged BW
PALV

DRILLERS REMARKS:

description of formations encountered	from	to
Red & white Clay	0	10
Blue & white clay	10	30
RED SAND	30	114
Blue clay	114	451
Gray SAND	451	495

CODED

APR - 8 1970
MISS. BD. OF WATER CO.

If well telescopes please sketch and show depths.

GROUND LEVEL

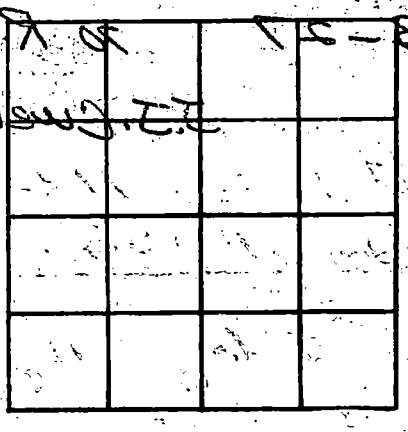

SECTION _____

Please indicate well location X.

ADDITIONAL INFORMATION

If more than one screen, show locations of each on sketch.