HARRISON
F109
12-6-71

MISSISSIPPI
BOARD OF WATER COMMISSIONERS
416 North State Street
Jackson, Mississippi 39201

CODED

WATER WELL DRILLERS LOG

MISS. BD. OF

12-6 1971 Switzer Well Co. Harrison
date well completed — firm name — county well located

LANDOWNER: R.H. Dombrino
Rt 2 Box 373
Gulfport, Miss. 39501
(mailing address)

WELL LOCATION:
sec. 22 T 6 S R 12 W
9¼ miles NW of Gulfport
(distance) (direction) (nearest town)

WELL PURPOSE: Home
(home, irrigation, municipal, industrial)

WELL COMPLETION DATA:

(1) diameter (inches) 2"

(2) total depth (feet) 642'

(3) static water level (feet) 6'6" below above top of ground.

(4) casing galv. (material), 642' (depth),
_____ (size) if telescope see back.

(5) screen 10' (length), 632' (depth to top)
.008 (size), stainless steel (material)

(6) pump 1 (HP) 10 (yield gpm)
Electric (type power)

(7) electric log No (yes or no)
_____ (organization running log)

(8) how well bottom plugged back
pressure valve

DRILLERS REMARKS:

description of formations encountered	from	to
Clay - Sand mixed	0	23
Clay	23	44
Clay & sand mixed	44	65
Clay streaks	65	86
Sand	86	102
Shells - clay mixed	102	129
Shells	129	136
Clay	136	150
Sand, good	150	171
Sand, fine	171	184
Clay	184	219
Sand, fine	219	241
Clay	241	318
Sand, fine	318	321
Shell - clay mixed	321	343
Shell	343	345
Sand, fine	345	374
Clay	374	383
Sand	383	385
Shell - clay mixed	385	406
Clay	406	472
Shell - clay mixed	472	535
Sand, fine	535	539
Clay	539	560
Sand, fine	560	600
Sand, good	600	642

CODED

If well telescopes please sketch and show depths.

GROUND LEVEL

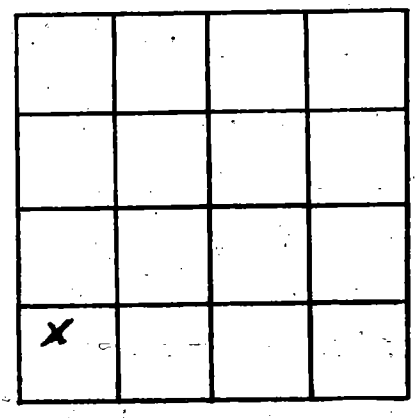

SECTION 23

Please indicate well location X.

ADDITIONAL INFORMATION

If more than one screen, show locations of each on sketch.