HARRISON
F119
6-5-72

MISSISSIPPI
BOARD OF WATER COMMISSIONERS
416 North State Street
Jackson, Mississippi 39201

CODED

WATER WELL DRILLERS LOG

6-5-72 19 — R. J. Moore — HARRISON
date well completed — firm name — county well located

LANDOWNER: R. W. MORAN
RT #1
STARCKER MISS
(mailing address)

WELL LOCATION:
sec. 2 T 6 N (S) R 12 E (W)
4 (distance) miles SW (direction) of STARCKER (nearest town)

WELL PURPOSE: (home, irrigation, municipal, industrial)

WELL COMPLETION DATA:
(1) diameter (inches) 2"
(2) total depth (feet) 326'
(3) static water level (feet) 54 below above top of ground.
(4) casing PVC (material), 316' (depth),
(size) if telescope see back.
(5) screen 2"x10' (length), 316' (depth to top)
(size), SS (material)
(6) pump 1 (HP) 6 (yield gpm)
E (type power)
(7) electric log (yes or no)
(organization running log)
(8) how well bottom plugged BW
Water

DRILLERS REMARKS:

description of formations encountered	from	to
TOP SOIL	0	10
Red Clay & Sand	10	60
White Clay	60	120
Blue Clay	120	300
Med gray Sand	300	326

CODED

If well telescopes please sketch and show depths.

GROUND LEVEL

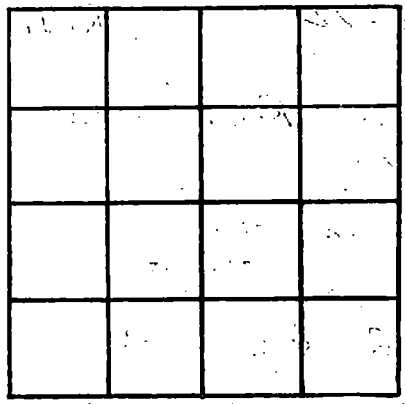

SECTION _____

Please indicate well location X.

ADDITIONAL INFORMATION

If more than one screen, show locations of each on sketch.