MISSISSIPPI DEPARTMENT OF NATURAL RESOURCES

Bureau of Land and Water Resources

P.O. Box 10631
Jackson, Mississippi 39209

WATER WELL DRILLERS LOG

COUNTY WELL LOCATED: Harrison	
WELL NUMBER: F 2058	CODED
DATE WELL COMPLETED: [illegible]	
PERMIT NUMBER	
NAME OF DRILLING FIRM: McHell Campbells	

NAME & MAILING ADDRESS OF LANDOWNER: Kurt Pippin, 5355 [illegible], Gulfport, Ms. [illegible]

WELL LOCATION: SEC	TOWNSHIP	RANGE
33	6 N (S)	12 E (W)

DISTANCE	DIRECTION	NEAREST TOWN
6 Miles	North of	Gulfport

OTHER LANDMARK:

WELL PURPOSE: Home, Irrigation, Municipal, Industrial, Fish Pond, etc.: Home

PUMP DATA

PUMP TYPE (Circle One): Submersible, Turbine, (Jet) Flowing Well, Other (Describe) _____

POWER TYPE (Circle One): (Electric) Tractor, Diesel, Gasoline, Butane, Other (Describe) _____

Pump Capacity (GPM)	No. of Stages	Setting Depth
12	[illegible]	60' FT.

PUMP TEST

Well yielded 12 GPM with a drawdown of 5 ft. after 1 hours of pumping

WELL DATA

Well Depth	Casing Diameter (In.)	Casing Length (Ft.)
220'	2"	220'

Type of Casing	Hole Depth	Depth to Static Water Level
PVC	225'	35

TYPE OF COMPLETION: (Circle One or More): Gravel Packed, Underreamed, Telescoped, (Natural Development) Open Hole, Other (Describe) _____

Top of Lap Pipe or Reduction in Casing: FEET

IF TELESCOPED OR MORE THAN ONE SCREEN: USE BACK PAGE

LOG DATA

TYPE OF LOG RUN (Circle One): (No Log Run) Electric, Gamma Ray, Density, Sonic, Neutron, Other (Describe) _____

Name of Organization Running Log

GEOLOGIC DATA (Office Use Only)

Surface Elev.	Geologic Unit	Unit Thickness	Depth to Top
Subs. SWL	Date	Analysis	Aquifer Test

Driller's Remarks

SCREEN DATA

Diameter - Inches	Length - Feet	Slot Size - Inches
2"	10	6 Ths

Screen Type	Depth to Bottom - Feet
PVC	220'

DESCRIPTION OF FORMATIONS ENCOUNTERED	FROM	TO
mud	0	10
Sand	10	40
mud	40	80
Sand	80	100
mud	100	170
Sand	170	230

FORMATIONS (Continued)	FROM	TO

RECEIVED
NOV 3 1986
Department of Natural Resources
Bureau of Land & Water Resources

IF MORE SPACE IS NEEDED, USE BACK

If well telescopes please
sketch and show depths.

GROUND LEVEL

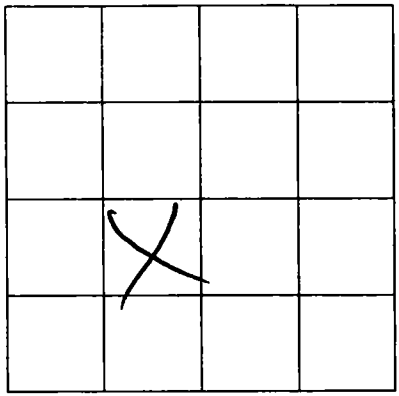

SECTION _____

Please indicate well location X.

ADDITIONAL INFORMATION

If more than one screen,
show location of each on sketch.