# MISSISSIPPI DEPARTMENT OF NATURAL RESOURCES

Bureau of Land and Water Resources

P.O. Box 10631
Jackson, Mississippi 39209

WATER WELL DRILLERS LOG

| | |
|---|---|
| COUNTY WELL LOCATED: Harrison | PERMIT NUMBER: O-239 |
| WELL NUMBER: F 2088 CODED | NAME OF DRILLING FIRM: MCGEE PUMP & WELLS |
| | RT1 BOX 1643 CANAL RD |
| DATE WELL COMPLETED: 2-16-87 | GULPT, MS 39503 |

**NAME & MAILING ADDRESS OF LANDOWNER**

Edith Carpenter
Rt. 3, Box 573
Gulfport Ms.

**WELL LOCATION**

| SEC | TOWNSHIP | RANGE |
|---|---|---|
| 6 | 6 (N) (S) | 12 (E) (W) |

| DISTANCE | DIRECTION | NEAREST TOWN |
|---|---|---|
| 4 Miles | WEST of | Lyman |

OTHER LANDMARK:

WELL PURPOSE: Home, Irrigation, Municipal, Industrial, Fish Pond, etc.

## PUMP DATA

PUMP TYPE (Circle One): Submersible, Turbine, Jet, Flowing Well, Other (Describe) ____

POWER TYPE (Circle One): Electric, Tractor, Diesel, Gasoline, Butane, Other (Describe) ____

| Pump Capacity (GPM) | No. of Stages | Setting Depth |
|---|---|---|
| 9 | 2 | 100' FT. |

PUMP TEST

Well yielded 9 GPM with a drawdown of 5 ft. after 1 hours of pumping

## WELL DATA

| Well Depth | Casing Diameter (In.) | Casing Length (Ft.) |
|---|---|---|
| 500' | 2" | 480' |

| Type of Casing | Hole Depth | Depth to Static Water Level |
|---|---|---|
| PVC | 500' | 80' |

TYPE OF COMPLETION: (Circle One or More): Gravel Packed, Underreamed, Telescoped, Natural Development, Open Hole, Other (Describe) ____

Top of Lap Pipe or Reduction in Casing: FEET

IF TELESCOPED OR MORE THAN ONE SCREEN: USE BACK PAGE

## SCREEN DATA

| Diameter - Inches | Length - Feet | Slot Size - Inches |
|---|---|---|
| 2" | 10' | 6ths |

| Screen Type | Depth to Bottom - Feet |
|---|---|
| PVC-Sch 80 | 500' |

## LOG DATA

TYPE OF LOG RUN (Circle One): No Log Run, Electric, Gamma Ray, Density, Sonic, Neutron, Other (Describe) ____

Name of Organization Running Log:

## GEOLOGIC DATA (Office Use Only)

| Surface Elev. | Geologic Unit | Unit Thickness | Depth to Top |
|---|---|---|---|
| Subs. SWL | Date | Analysis | Aquifer Test |

Driller's Remarks:

RECEIVED
APR 14 1987
Department of Natural Resources
Bureau of Land & Water Resources

| DESCRIPTION OF FORMATIONS ENCOUNTERED | FROM | TO | FORMATIONS (Continued) | FROM | TO |
|---|---|---|---|---|---|
| | | | | | |
| | | | | | |
| | | | IF MORE SPACE IS NEEDED, USE BACK | | |

If well telescopes please
sketch and show depths.

GROUND LEVEL

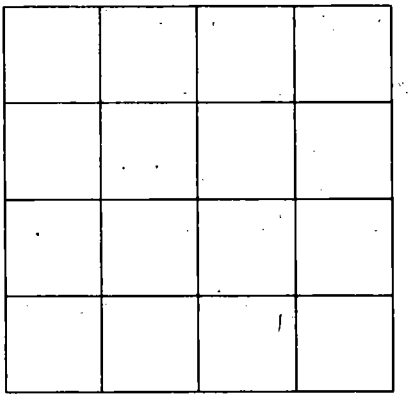

SECTION _____

Please indicate well location X.

ADDITIONAL INFORMATION

If more than one screen,
show location of each on sketch.