MISSISSIPPI DEPARTMENT OF NATURAL RESOURCES

Bureau of Land and Water Resources

P.O. Box 10631
Jackson, Mississippi 39209

WATER WELL DRILLERS LOG

COUNTY WELL LOCATED: Harrison	
WELL NUMBER: F2100	CODED:
DATE WELL COMPLETED: 1-7-87	PERMIT NUMBER:
	NAME OF DRILLING FIRM: Mac B Drilling Co.

NAME & MAILING ADDRESS OF LANDOWNER
Cody Petermen
Hiway 53
Gulfport, Miss.

WELL LOCATION: SEC 24 TOWNSHIP 6 S RANGE 12 W

DISTANCE 2 Miles DIRECTION W of NEAREST TOWN Lyman

OTHER LANDMARK

WELL PURPOSE: Home, Irrigation, Municipal, Industrial, Fish Pond, etc.
Home & Body Shop

PUMP DATA

PUMP TYPE (Circle One): Submersible, Turbine, Jet, Flowing Well, Other (Describe)

POWER TYPE (Circle One): Electric, Tractor, Diesel, Gasoline, Butane, Other (Describe)

Pump Capacity (GPM)	No. of Stages	Setting Depth
20		140 FT.

PUMP TEST

Well yielded 20 GPM with a drawdown of _____ ft. after _____ hours of pumping

WELL DATA

Well Depth	Casing Diameter (In.)	Casing Length (Ft.)
280	4" X 2"	260
Type of Casing	**Hole Depth**	**Depth to Static Water Level**
PVC	280	55

TYPE OF COMPLETION: (Circle One or More): Gravel Packed, Underreamed, Telescoped, Natural Development, Open Hole, Other (Describe)

Top of Lap Pipe or Reduction in Casing FEET

IF TELESCOPED OR MORE THAN ONE SCREEN: USE BACK PAGE

LOG DATA

TYPE OF LOG RUN (Circle One): No Log Run, Electric, Gamma Ray, Density, Sonic, Neutron, Other (Describe)

Name of Organization Running Log

GEOLOGIC DATA (Office Use Only)

Surface Elev.	Geologic Unit	Unit Thickness	Depth to Top
Subs. SWL	Date	Analysis	Aquifer Test

Driller's Remarks

SCREEN DATA

Diameter - Inches	Length - Feet	Slot Size - Inches
2	10	.008
Screen Type	**Depth to Bottom - Feet**	
PVC WOP	270	

RECEIVED
AUG 26 1987
Department of Natural Resources
Bureau of Land & Water Resources

DESCRIPTION OF FORMATIONS ENCOUNTERED	FROM	TO	FORMATIONS (Continued)	FROM	TO
Surface	0	3			
Brown & White Clay	3	40			
Clay & Sand Breaks	40	120			
White Sand	120	150			
Blue Clay	150	210			
Gray Sand	210	270			
Blue Clay	270	270 +			
			IF MORE SPACE IS NEEDED, USE BACK		

If well telescopes please sketch and show depths.

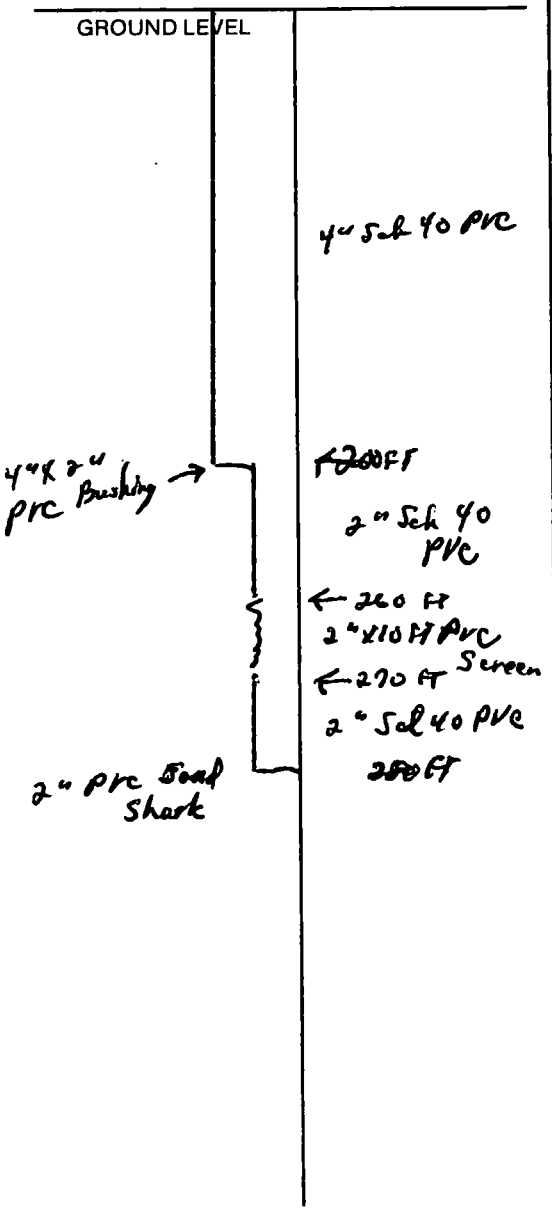

If more than one screen, show location of each on sketch.

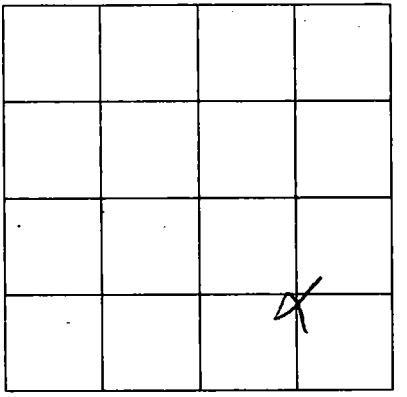

SECTION 24

Please indicate well location X.

ADDITIONAL INFORMATION