MISSISSIPPI DEPARTMENT OF NATURAL RESOURCES

Bureau of Land and Water Resources

P.O. Box 10631
Jackson, Mississippi 39209

WATER WELL DRILLERS LOG

COUNTY WELL LOCATED: Harrison	PERMIT NUMBER:
WELL NUMBER: F 2110 CODED:	NAME OF DRILLING FIRM: M & B Drilling Co.
DATE WELL COMPLETED: 9-18-89	

NAME & MAILING ADDRESS OF LANDOWNER
Bud McCowan
20360 Westlake Court
Twin Lakes Subdivision
Saucier, Miss. 39574

WELL LOCATION	SEC	TOWNSHIP	RANGE
	3	6 S	12 W

DISTANCE	DIRECTION	NEAREST TOWN
6 Miles	SW	of Saucier

OTHER LANDMARK:

WELL PURPOSE: Home, Irrigation, Municipal, Industrial, Fish Pond, etc.
Home

PUMP DATA

PUMP TYPE (Circle One): Submersible, Turbine, (Jet) Flowing Well, Other (Describe) ____

POWER TYPE (Circle One): (Electric) Tractor, Diesel, Gasoline, Butane, Other (Describe) ____

Pump Capacity (GPM)	No. of Stages	Setting Depth
12	2	60 FT.

PUMP TEST

Well yielded ____ GPM with a drawdown of ____ ft. after ____ hours of pumping

WELL DATA

Well Depth	Casing Diameter (In.)	Casing Length (Ft.)
220	2"	185

Type of Casing	Hole Depth	Depth to Static Water Level
PVC	220	45

TYPE OF COMPLETION: (Circle One or More): Gravel Packed, Underreamed, Telescoped, (Natural Development) Open Hole, Other (Describe) ____

Top of Lap Pipe or Reduction in Casing: FEET

IF TELESCOPED OR MORE THAN ONE SCREEN: USE BACK PAGE

LOG DATA

TYPE OF LOG RUN (Circle One): (No Log Run), Electric, Gamma Ray, Density, Sonic, Neutron, Other (Describe) ____

Name of Organization Running Log

GEOLOGIC DATA (Office Use Only)

Surface Elev.	Geologic Unit	Unit Thickness	Depth to Top
Subs. SWL	Date	Analysis	Aquifer Test

Driller's Remarks
25 FT Tailpipe

SCREEN DATA

Diameter - Inches	Length - Feet	Slot Size - Inches
2	10	.008

Screen Type	Depth to Bottom - Feet
PVC WOP	195

DESCRIPTION OF FORMATIONS ENCOUNTERED	FROM	TO
Surface	0	6
Red Clay	6	30
Sand & Gravel	30	40
White Clay	40	70
White Sand	70	90
Blue Clay	90	150
Gray Sand - Fine	150	195
Blue Clay	195	220

FORMATIONS (Continued)	FROM	TO

IF MORE SPACE IS NEEDED, USE BACK

RECEIVED
FEB 22 1989
Department of Natural Resources
Bureau of Land & Water Resources

If well telescopes please
sketch and show depths.

GROUND LEVEL

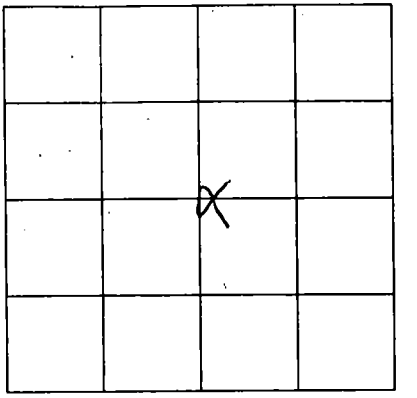

SECTION 3

Please indicate well location X.

ADDITIONAL INFORMATION

If more than one screen,
show location of each on sketch.