MISSISSIPPI DEPARTMENT OF ENVIRONMENTAL QUALITY
Office of Land and Water Resources

P. O. Box 10631
Jackson, MS 39289-0631

WATER WELL DRILLERS LOG

COUNTY WELL LOCATED: Harrison	
WELL NUMBER: 2	CODED: F-2221
DATE WELL COMPLETED: 6-11-99	
PERMIT NUMBER: 0-493	
NAME OF DRILLING FIRM: Beech's Well Works	

NAME & MAILING ADDRESS OF LANDOWNER
Steven P. Harrison
Big Creek Rd.
Gulfport MS 39503

WELL LOCATION	SEC	TOWNSHIP	RANGE
	21	6 N (S)	12 E (W)

DISTANCE	DIRECTION	NEAREST TOWN
Miles	of	

OTHER LANDMARK

WELL PURPOSE: (Home) Irrigation, Municipal, Industrial, Fish Pond, etc.

PUMP DATA

PUMP TYPE (Circle One): (Submersible.) Turbine. Jet Flowing Well. Other (Describe) _____

POWER TYPE (Circle One): (Electric.) Tractor. Diesel. Gasoline. Butane. Other (Describe) _____ H/P _____

Pump Capacity (GPM)	No of Stages	Setting Depth
20	7	80 FT.

PUMP TEST

Well yielded _____ GPM with

a drawdown of _____ ft.

after _____ hours of pumping

WELL DATA

Well Depth	Casing Diameter (In)	Casing Length (Ft)
341	2X4	321
Type of Casing	**Hole Depth**	**Depth to Static Water Level**
PVC	341	17 ft.

TYPE OF COMPLETION: (Circle One or More):
Gravel Packed. Underreamed. Telescoped. (Natural Development.) Open Hole. Other (Describe) _____

WELL GROUTED TO A DEPTH OF 10 FEET
Type Grout (circle one): (Cement) Bentonite, or Mix

LOG DATA

TYPE OF LOG RUN (Circle One): (No Log Run) Electric. Gamma Ray. Density. Sonic. Neutron. Other (Describe) _____

Name of Organization Running Log

GEOLOGIC DATA (Office Use Only)

Surface Elev	Geologic Unit	Unit Thickness	Depth to Top
Subs. SWL	Date	Analysis	Aquifer Test

Driller's Remarks

Top of Lap Pipe or Reduction in Casing
FEET — IF TELESCOPED OR MORE THAN ONE SCREEN: USE BACK PAGE

SCREEN DATA

Diameter - Inches	Length - Feet	Slot Size - Inches
2X4	20	.006
Screen Type	**Depth to Bottom - Feet**	
PVC		

DESCRIPTION OF FORMATIONS ENCOUNTERED	FROM	TO
Clay	0	121
Sand	121	148
Clay	148	265
Sand	265	275
Blue clay	275	319
Green sand	319	341

FORMATIONS (Continued)	FROM	TO
IF MORE SPACE IS NEEDED, USE BACK		

REC'D MAY 08 2001

If well telescopes please sketch and show depths.

GROUND LEVEL

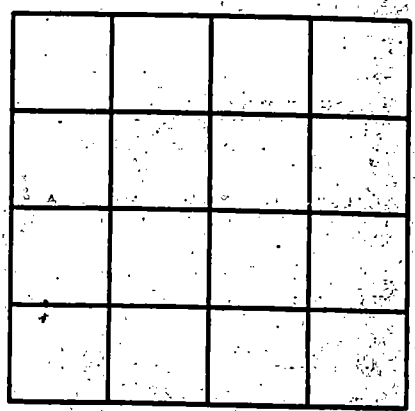

SECTION _____

Please indicate well location X.

ADDITIONAL INFORMATION

If more than one screen,