MISSISSIPPI DEPARTMENT OF ENVIRONMENTAL QUALITY
Office of Land and Water Resources

P. O. Box 10631
Jackson, MS 39289-0631
WATER WELL DRILLERS LOG

COUNTY WELL LOCATED: Harrison	
WELL NUMBER: F-20226	CODED:
DATE WELL COMPLETED: 8/12/99	
PERMIT NUMBER: 0-239	
NAME OF DRILLING FIRM: The Well Pump & well	

NAME & MAILING ADDRESS OF LANDOWNER: Dan & Vanderver.
Hunter Ridge Rd
Gulfport, MS. 39503

WELL LOCATION: not listed SEC 23 TOWNSHIP 6 (S) RANGE 12 (W) E

DISTANCE: 3 Miles DIRECTION: N of NEAREST TOWN: Gft.

OTHER LANDMARK:

WELL PURPOSE: (Home) Irrigation, Municipal, Industrial, Fish Pond, etc.

PUMP DATA

PUMP TYPE (Circle One): (Submersible) Turbine, Jet Flowing Well, Other (Describe)

POWER TYPE (Circle One): (Electric) Tractor, Diesel, Gasoline, Butane, Other (Describe) H/P 1

Pump Capacity (GPM)	No. of Stages	Setting Depth
25	2	120 FT.

PUMP TEST

Well yielded 25 GPM with a drawdown of 5 ft. after 5 hours of pumping

WELL DATA

Well Depth	Casing Diameter (In.)	Casing Length (Ft.)
400	4x2	380
Type of Casing	**Hole Depth**	**Depth to Static Water Level**
PVC	400	80

TYPE OF COMPLETION: (Circle One or More): Gravel Packed, Underreamed, Telescoped, (Natural Development), Open Hole, Other (Describe)

WELL GROUTED TO A DEPTH OF 10 FEET
Type Grout (circle one): Cement, Bentonite, or Mix

LOG DATA

TYPE OF LOG RUN (Circle One): No Log Run, Electric, Gamma Ray, Density, Sonic, Neutron, Other (Describe) Hand auger

Name of Organization Running Log

GEOLOGIC DATA (Office Use Only)

Surface Elev.	Geologic Unit	Unit Thickness	Depth to Top
Subs. SWL	Date	Analysis	Aquifer Test

Driller's Remarks

Top of Lap Pipe or Reduction in Casing FEET

IF TELESCOPED OR MORE THAN ONE SCREEN: USE BACK PAGE

SCREEN DATA

Diameter - Inches	Length - Feet	Slot Size - Inches
2"	20	.006
Screen Type		**Depth to Bottom - Feet**
PVC		400

DESCRIPTION OF FORMATIONS ENCOUNTERED	FROM	TO	FORMATIONS (Continued)	FROM	TO
Sand	0	40			
mud	40	140			
Sand	140	180			
mud	180	240			
Sand clay	240	300			
mud	300	340			
Sand	340	400			
			IF MORE SPACE IS NEEDED, USE BACK		

REC'D JUN 25 2001

If well telescopes please
sketch and show depths.

GROUND LEVEL

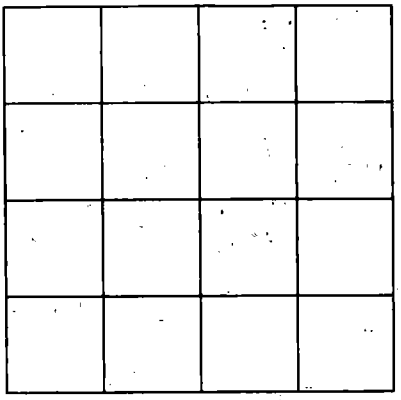

SECTION _____

Please indicate well location X.

ADDITIONAL INFORMATION

If more than one screen,
show location of each on sketch.