Harrison
G 101
3-68

MISSISSIPPI BOARD OF WATER COMMISSIONERS
416 North State Street
Jackson, Mississippi 39201

CODED

WATER WELL DRILLERS LOG

3-4 1968 Switzer Well Co. Harrison
date well completed — firm name — county well located

LANDOWNER: Robinwood
Guernsey Farm
Hwy 49, Saucier Miss
(mailing address)

WELL LOCATION:
sec. 6 T. 6 S R. 11 W
4 miles N of LYMAN
(distance) (direction) (nearest town)

WELL PURPOSE: DAIRY
(home, irrigation, municipal, industrial)

WELL COMPLETION DATA:

(1) diameter (inches) 4 x 3
(2) total depth (feet) 700
(3) static water level (feet) 40 below ~~above~~ top of ground.
(4) casing gal steel (material), 670' (depth),
4 x 3 (size) If telescope see back.
(5) screen 30' (length), 670' (depth to top)
3" 8 ga SS on pipe (size) (material)
(6) pump 5 (HP) 60 GPM (yield gpm)
electric (type power)
(7) electric log No (yes or no)
(organization running log)
(8) how well bottom plugged Back pressure valve

DRILLERS REMARKS:

description of formations encountered	from	to
clay	0	21
sand + gravel	21	36
clay	36	111
sand	111	126
clay	126	155
sand	155	165
clay	165	268
sand	268	285
clay	285	307
sand	307	328
mixed	328	372
fair sand	372	394
sand	394	399
clay	399	431
sand	431	441
fair sand	441	461
sand	461	469
clay	469	550
sand	550	555
clay	555	572
mixed	572	586
sand	586	594
fair sand	594	612
clay	612	631
sand	631	636
fair sand	636	659
sand	659	681
good sand	681	702
total depth 700		

CODED

MAR 27 1968 MISS. BOARD OF WATER COMM.

If well telescopes please sketch and show depths.

GROUND LEVEL

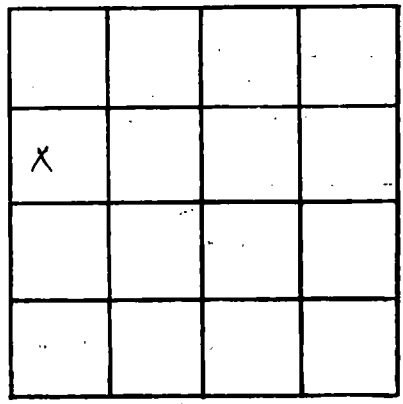

SECTION 6

Please indicate well location X.

ADDITIONAL INFORMATION

If more than one screen, show locations of each on sketch.