CODED

HARRISON
G-119
8-10-71

MISSISSIPPI
BOARD OF WATER COMMISSIONERS
416 North State Street
Jackson, Mississippi 39201

WATER WELL DRILLERS LOG

CODED

8-10-71 19 — date well completed
R. V. Moore — firm name
HARRISON — county well located

LANDOWNER: Louis LOTT
P.O. Box 212
LYMAN, MISS
(mailing address)

WELL LOCATION:
sec. 29 T. 6 N (S) R. 11 E (W)
1 N LYMAN
miles (distance) (direction) of (nearest town)

WELL PURPOSE: (home, irrigation, municipal, industrial)

WELL COMPLETION DATA:

(1) diameter (inches) 2"
(2) total depth (feet) 377'
(3) static water level (feet) 64' below above top of ground.
(4) casing PVC (material), 266' (depth),
(size) if telescope see back.
(5) screen 2x10 (length), 266' (depth to top)
2" (size), SS (material)
(6) pump — (HP) — (yield gpm)
(type power)
(7) electric log (yes or no)
(organization running log)
(8) how well bottom plugged Bw
Water

DRILLERS REMARKS:

description of formations encountered	from	to
TOP SOIL	0	15
red Sand	15	25
Red & white clay	25	50
blue clay	50	250
Coarse Gravel Sand	250	277

CODED

AUG 18 1971
MISS. BD. OF WATER COMM.

If well telescopes please sketch and show depths.

GROUND LEVEL

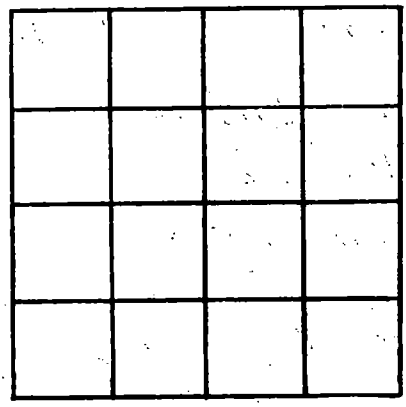

SECTION _____

Please indicate well location X.

ADDITIONAL INFORMATION

If more than one screen, show locations of each on sketch.