Harrison
G 132
9-19-69

MISSISSIPPI
BOARD OF WATER COMMISSIONERS
416 North State Street
Jackson, Mississippi 39201

CODED

WATER WELL DRILLERS LOG

9/19 1969 R T Moore HARRISON
date well completed — firm name — county well located

LANDOWNER: CARL F SHAW
PO 249 LYMAN, MISS
(mailing address)

WELL LOCATION:
sec 29 T 6 N (S) R 11 E (W)
OLD HIGHWAY 49 IN LYMAN
miles (distance) (direction) of (nearest town)

WELL PURPOSE: HOME
(home, irrigation, municipal, industrial)

WELL COMPLETION DATA:

(1) diameter (inches) 2"
(2) total depth (feet) 127'
(3) static water level (feet) 33' below above top of ground.
(4) casing GALV (material), 186' (depth), 2" (size) if telescope see back.
(5) screen 2 X 10 (length), 186' (depth to top), 2" (size), 95 (material)
(6) pump (HP) (yield gpm) (type power)
(7) electric log (yes or no) (organization running log)
(8) how well bottom plugged B.W. gravel

DRILLERS REMARKS:

description of formations encountered	from	to
TOP SOIL	0	16
RED SAND	16	25
WHITE + BLUE CLAY	25	60
BLUE CLAY	60	94
RED SAND (GRAY)	94	127

If well telescopes please sketch and show depths.

GROUND LEVEL

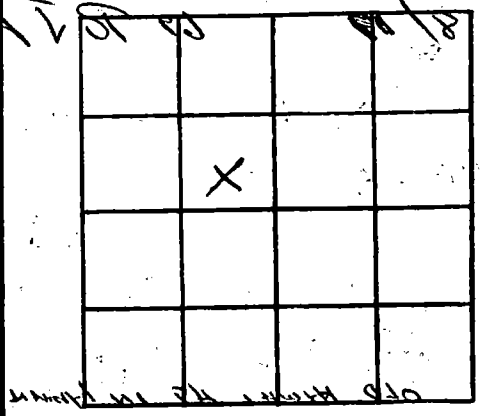

SECTION 29

Please indicate well location X.

ADDITIONAL INFORMATION

If more than one screen, show locations of each on sketch.