Harrison
G-145
3-6-70

MISSISSIPPI
BOARD OF WATER COMMISSIONERS
416 North State Street
Jackson, Mississippi 39201

CODED

# WATER WELL DRILLERS LOG

3-6 1970 R.J. MOORE HARRISON
date well completed — firm name — county well located

LANDOWNER: HARRY BENNETT
BILOXI RIVER ESTATE
GULFPORT MISS.
(mailing address)

WELL LOCATION:
sec 25 T 6 N (S) R 11 E (W)
1 (distance) miles West (direction) of WOOL MARKET (nearest town)

WELL PURPOSE: (home, irrigation, municipal, industrial)

WELL COMPLETION DATA:

(1) diameter (inches) 2"

(2) total depth (feet) 279'

(3) static water level (feet) 5' below above top of ground.

(4) casing GLAV (material), 269 (depth), 2" (size) if telescope see back.

(5) screen 2X10 (length), 269' (depth to top), 2' (size), SS (material)

(6) pump — (HP) — (yield gpm)
— (type power)

(7) electric log — (yes or no)
— (organization running log)

(8) how well bottom plugged BIN VALVE

DRILLERS REMARKS:

| description of formations encountered | from | to |
|---|---|---|
| TOP SOIL | 0 | 10 |
| White Coarse Sand | 10 | 50 |
| Blue CLAY | 50 | 146 |
| Fine Sand | 146 | 176 |
| Blue CLAY | 176 | 225 |
| Blue Sand | 225 | 279 |
| Blue Clay | 279 | 282 |

CODED

MAR 16 1970
MISS. BD. OF WATER COMM.

If well telescopes please sketch and show depths.

GROUND LEVEL

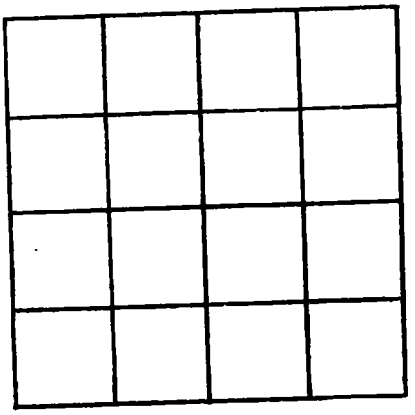

SECTION _____

Please indicate well location X.

ADDITIONAL INFORMATION

If more than one screen, show locations of each on sketch.